

Gidw.

PROJECT Phase II


SHEET _____ OF _____

SUBJECT _____

DATE 3-15-18

JOB NO. 4447

BY Atlas

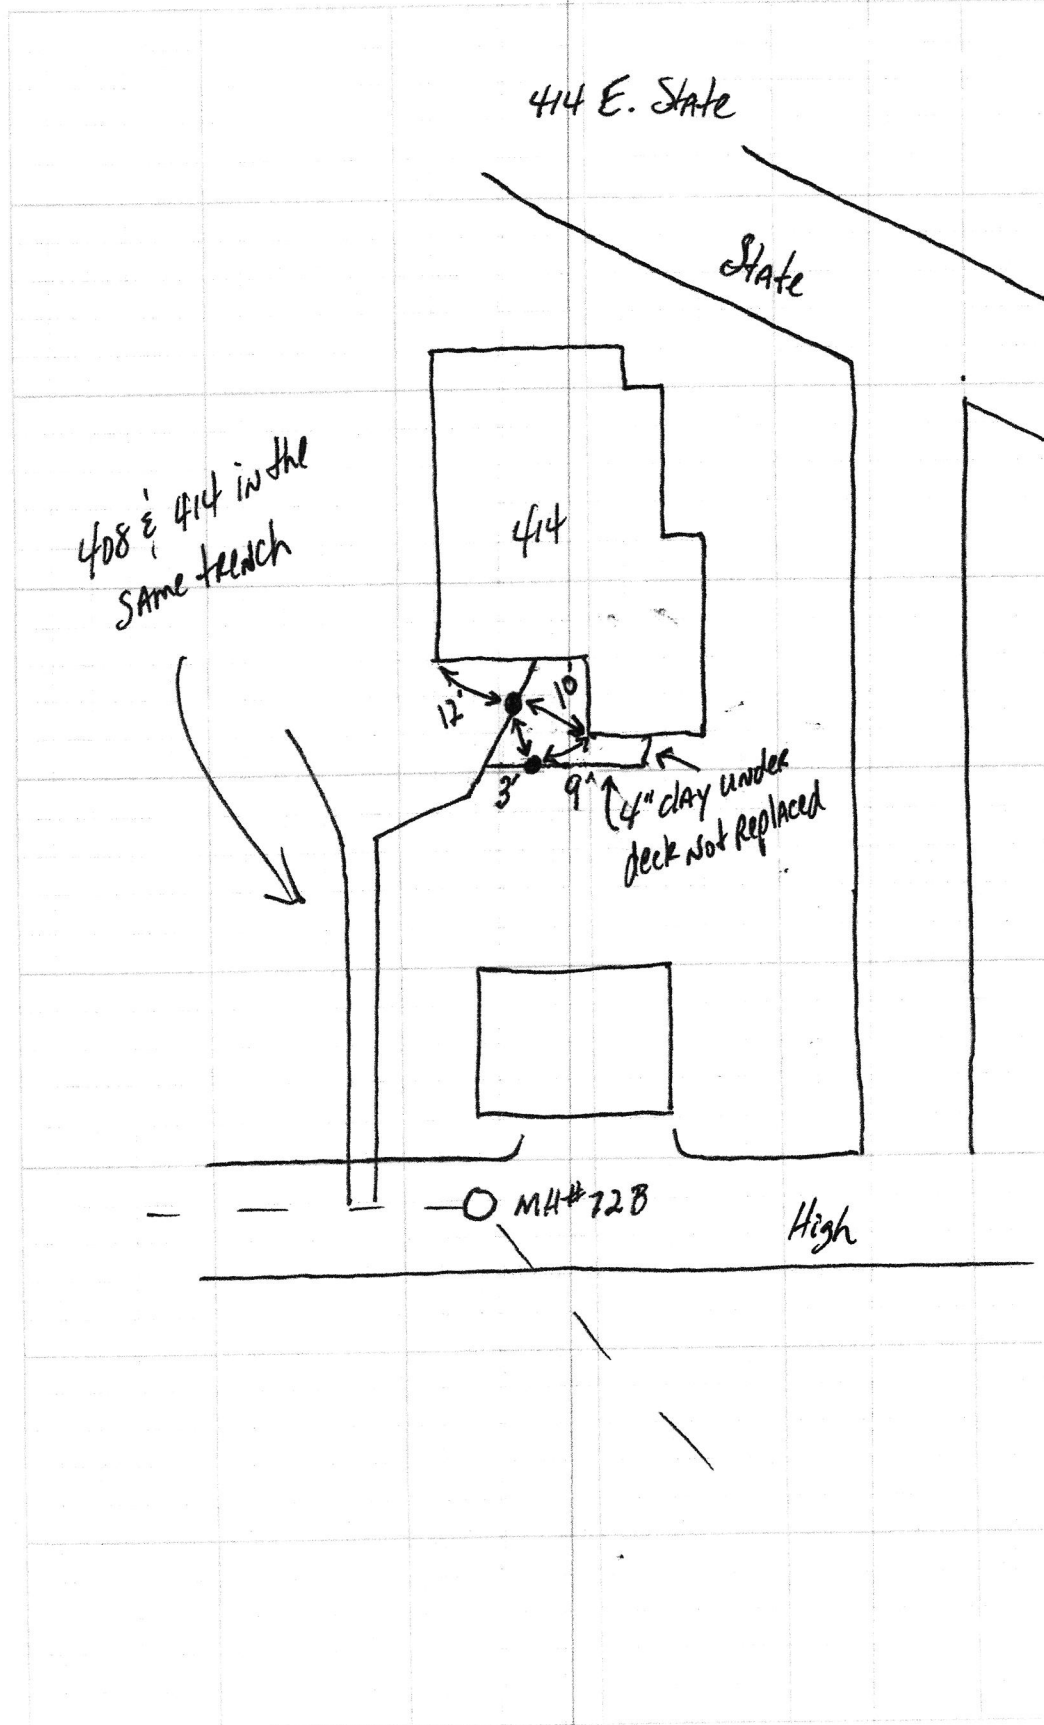

414 e state

SRP Phase II

