

Gidw.


PROJECT Phase II SHEET _____ OF _____

SUBJECT _____ DATE 3-2-18

JOB NO. 4447

BY Atlas

414 Franklin

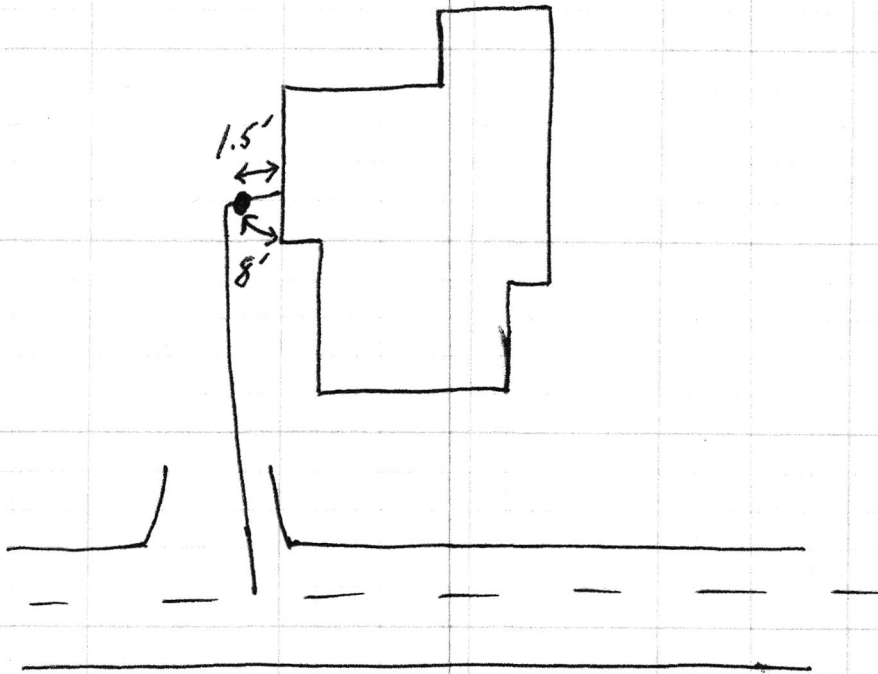

414 Franklin

SRP Phase II

