
#6687

Fall Creek Regional Waste District 9378 S 650 W, P.O. Box 59, Pendleton, IN 46064 765-778-7544 Agreement for Sanitary Sewer Service


This Agreement made and entered into this day of da	
Street Address: 414 MALLARD DRIVE	
Now therefore, the parties, in consideration of the mutual promises set out in this Agreement, the receipt and sufficiency of which is hereby acknowledged, agree as follows:	
 The Applicant agrees that all workmanship and materials shall conform to all District ordinances and the District's construction standards. District must accept and approve all work and materials before backfilling and final connection is made to the sewer mains. Any violation of this provision will cause all lines and appurtenances in violation to be removed and replaced at the Applicant's expense. The District shall have the right to enter upon the Applicant's premises at all reasonable times to inspect, repair, or replace any equipment used in connection with the District's service or which has an impact on said service. The Applicant shall be responsible for all monthly user rates, capacity charges, and tap fees. The failure to pay any rate charge or fee may result in a lien against the property and/or the termination of service to the property, the cost of which will be borne by Applicant, including, but not limited to, all attorney's fees and collection costs. The District shall not be responsible for any damages as a result of any failure to supply service unless said damages are due to default, neglect or culpability on the part of the District. If there is an available sanitary sewer within three hundred (300) feet of the property line, the property owner shall be required to connect to the District's sanitary sewer system. The Applicant and District agree that the provision of sanitary sewer service touches and concerns the property and the terms of this Agreement bind the District and Applicant and their heirs, executors, administrators, personal representatives, successors, agents, attorneys, assigns, designees, and transferees. 	
The parties hereto have read and fully understand the above provisions and agree to comply with said provisions. FALL CREEK REGIONAL WASTE DISTRICT APPLICANT APPLICANT	
Signature Signature	Signature
STATE OF INDIANA)) SS: COUNTY OF MADISON)	
SUBSCRIBED and sworn to before me this day of May, 2001	
My Commission Expires: EAL REBECCA LYNN HUNTER NOTARY PUBLIC-STATE OF INDIANA HAMILTON COUNTY Printed Rebecca Lynn Hunter	
MY COMM. EXPIRES NOV 19, 2023	otary Public esident of Hamilton County

Inspector Don Date Inspected 6-9-2/ Approved Rejected Rejected	
Date Reinspected Approved	Rejected
Notes: 1 / 1/2 25 / 176	Nejecteu
Size Pipe Type Pipe 55 () Basement Yes No	
Sump Pump <u>Yes</u> No	North
Downspout to Ground Yes No	
Septic Tank Pumped & Filled Yes No Contractor DR War Sov Ex	`
Special Conditions	Drawing
Existing Home	0,
New Construction	
	3 Pictures
	attached



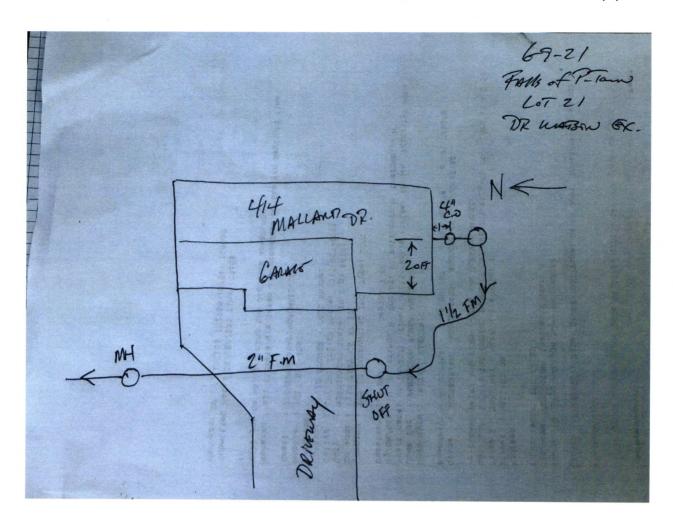



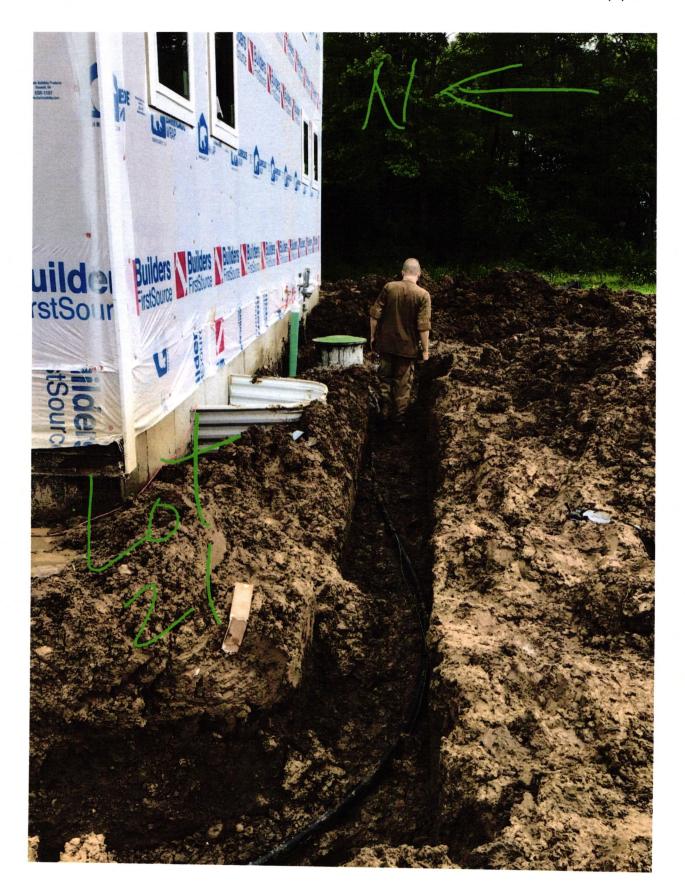

FALL CREEK REGIONAL WASTE DISTRI 9378 S 650 W PO BOX 59 PENDLETON, IN 46064 765-778-7544

FALL CREEK REGIONAL WASTE DIST

Date: 05/06/2021

10:00:27 AM

CREDIT CARD SALE

VISA

CARD NUMBER:

********5166 K

TOTAL AMOUNT:

\$33,331.66

APPROVAL CD:

064394

RECORD #:

000

CLERK ID:

Becca

CUST CODE:

Tap & Grinder

SALES TAX:

\$0.00

INVOICE #:

21 23 24 25 45

Thank you for your payment!

Customer Copy

Tap Fees

Lots Paid

1 2 5 7 14 18 20 21 23 24 25

\$760.00 x 11 = \$8360.00

Grinder Units

Lots Paid

18 20 21 23 24 25 45

\$3567.38 x 7 = \$24971.66

Units: \$23338.00 Tax: \$1633.66

Receipt # 11695