

Gidw.


PROJECT Phase II SHEET _____ OF _____

SUBJECT _____ DATE 2-26-18

JOB NO. 4447

BY Atlas

415 E. Madison

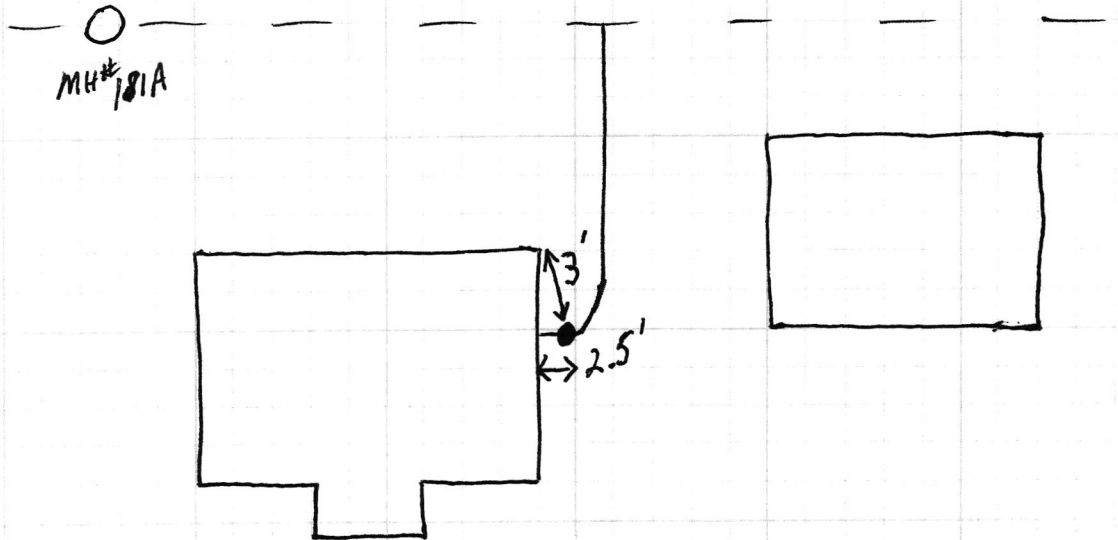

415 E Madison

SRP Phase II

