

Gidw.



PROJECT Phase II SHEET _____ OF _____

SUBJECT _____ DATE 3-5-18

JOB NO. 4447

BY Atlas

415 Franklin

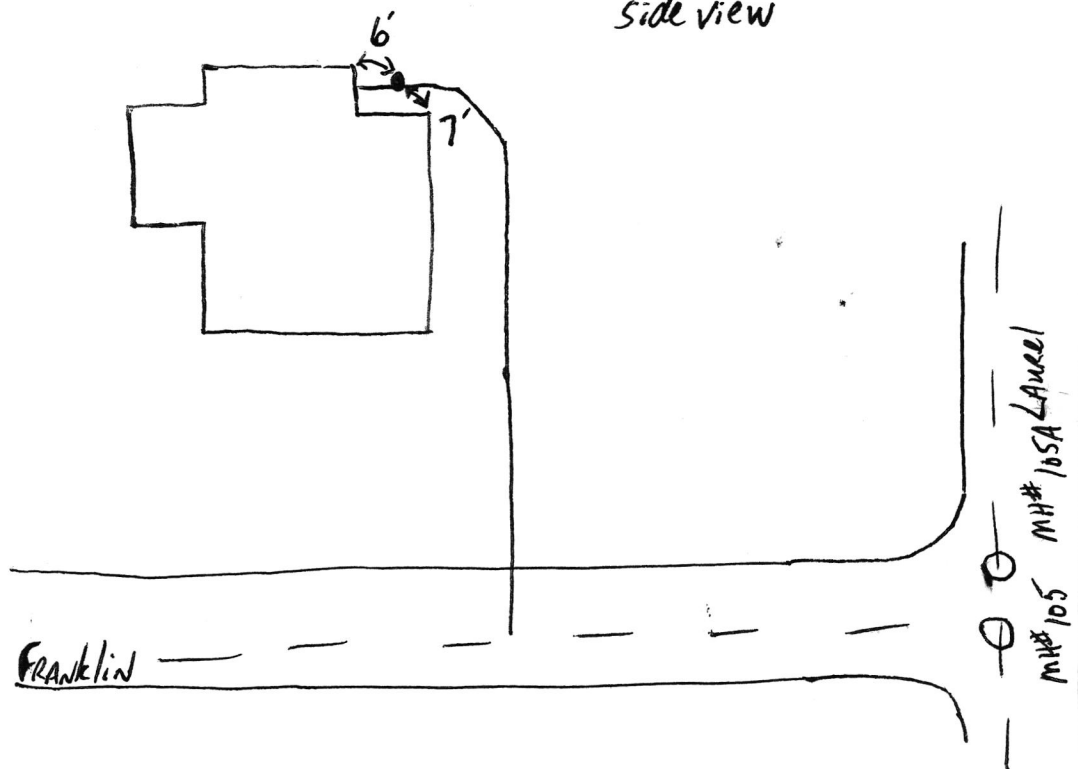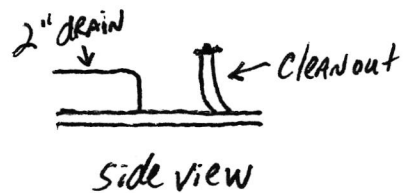

415

Franklin

SRP Phase II

