

Gidw.

PROJECT Phase II SHEET _____ OF _____


SUBJECT _____ DATE 5-21-18

JOB NO. 4447

BY Atlas

415. S. BROADWAY

← N

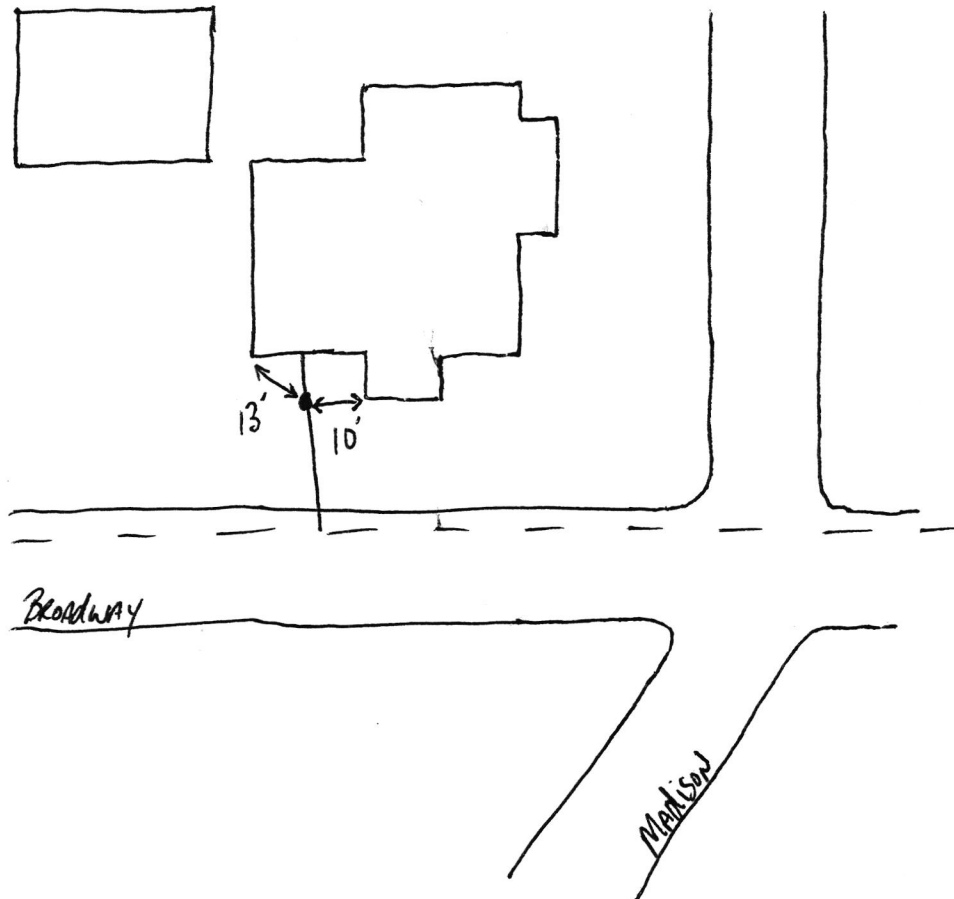

415 S Broadway

SRF Phase II

5.22.18

