

Gidw.


PROJECT Phase II SHEET _____ OF _____

SUBJECT _____ DATE 4-18-18

JOB NO. 4447

BY Atlas

415 W. State

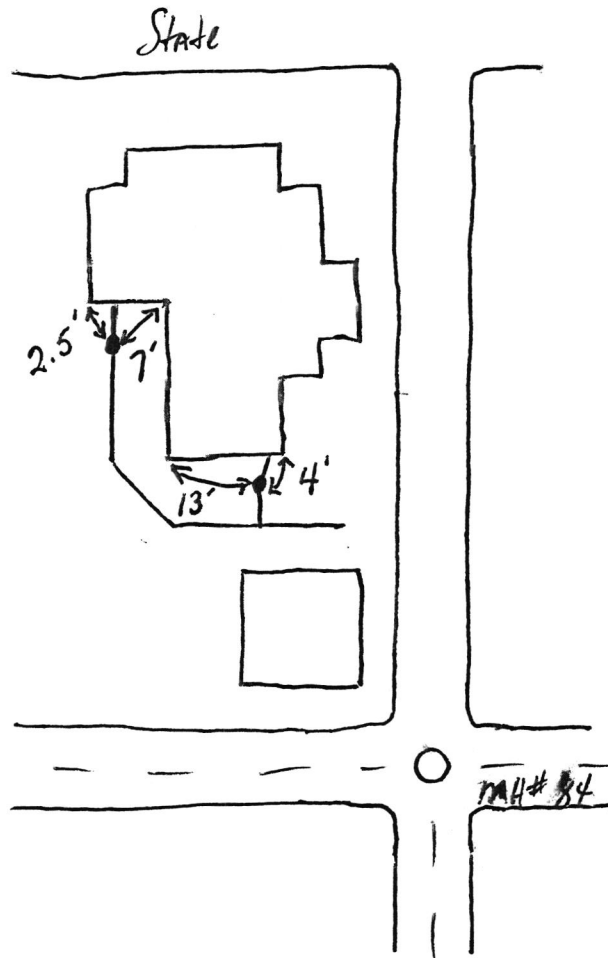

415 W State

SRP
Phase II

4-20-18



415 W State

SRP
Phase II

4.24.18

