


Gidw.

PROJECT Phase II SHEET _____ OF _____
SUBJECT _____ DATE 6-6-18
JOB NO. 4447
BY Atlas

416 S. East

N →

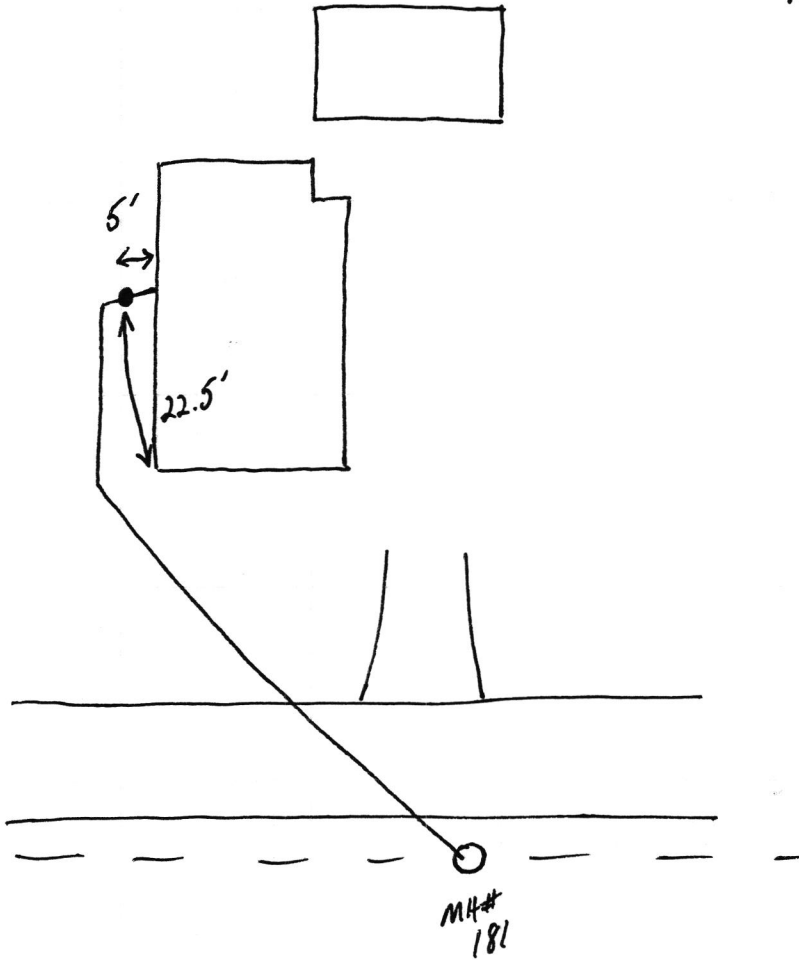

416 S East

SRF Phase II

6.11.18

