


Gidw.

PROJECT Phase II SHEET _____ OF _____

SUBJECT _____ DATE 6-7-18

JOB NO 4447

BY Atlas

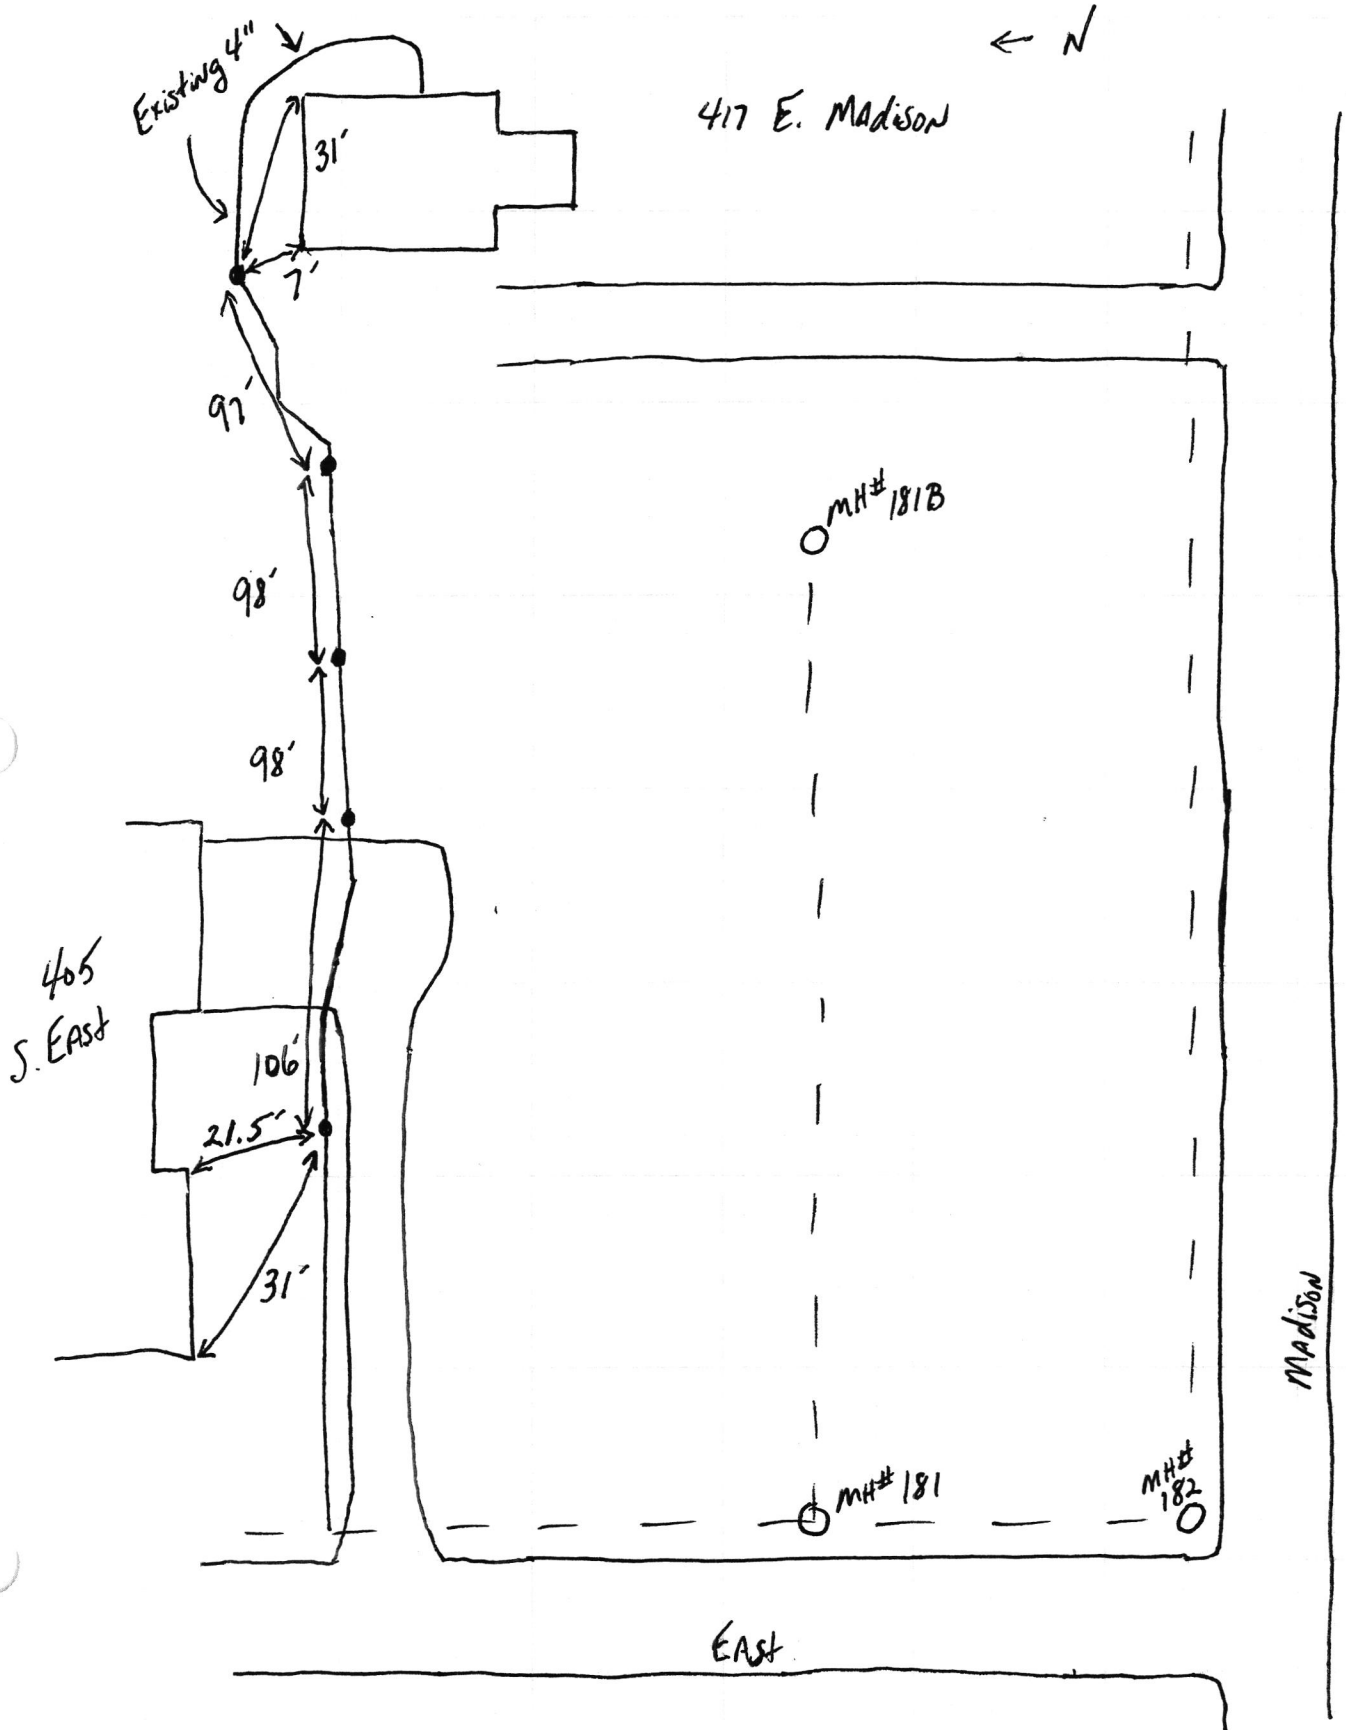

417 E Madison

SFP Phase II

6.11.18

