

G.R.W.


PROJECT Phase II SHEET _____ OF _____

SUBJECT _____ DATE 2-14-18

JOB NO. 4447

BY Atlas

417 W. Taylor

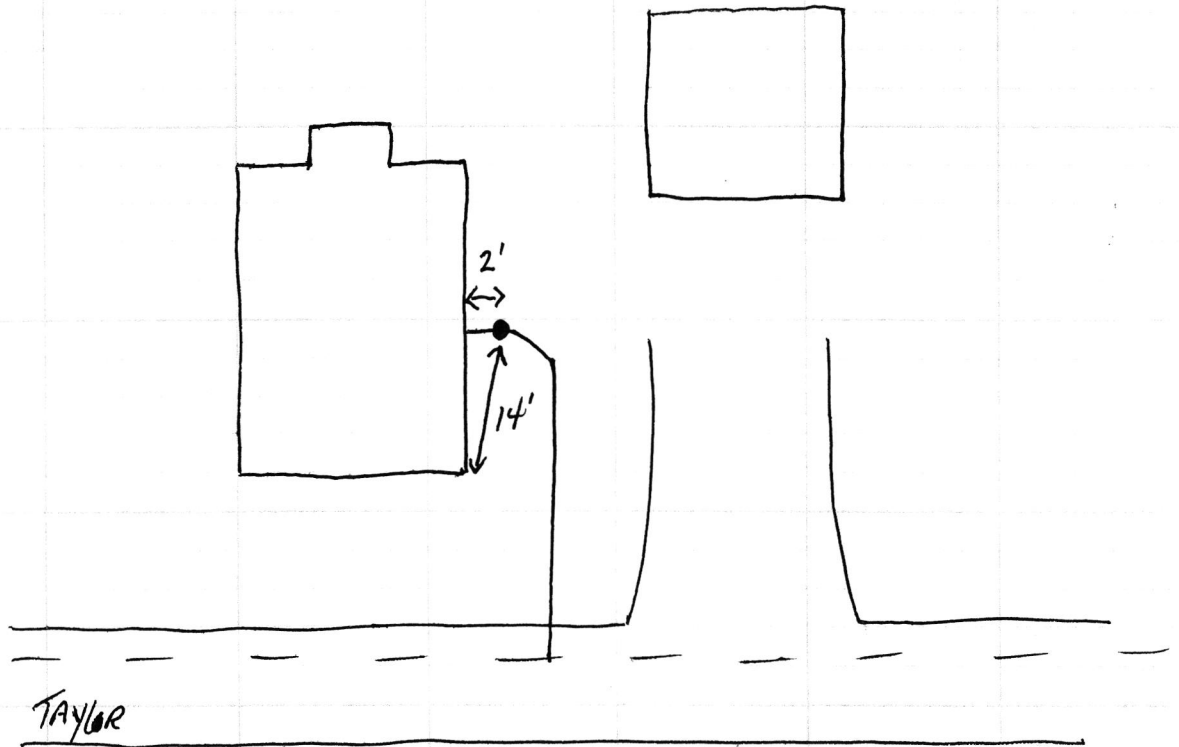

417 w Taylor

SRF Phase II

