

Gidw.

PROJECT Phase II SHEET _____ OF _____


SUBJECT _____ DATE 6-7-18

JOB NO. 4447

BY AHAS

419/421 E. Madison

↑
N

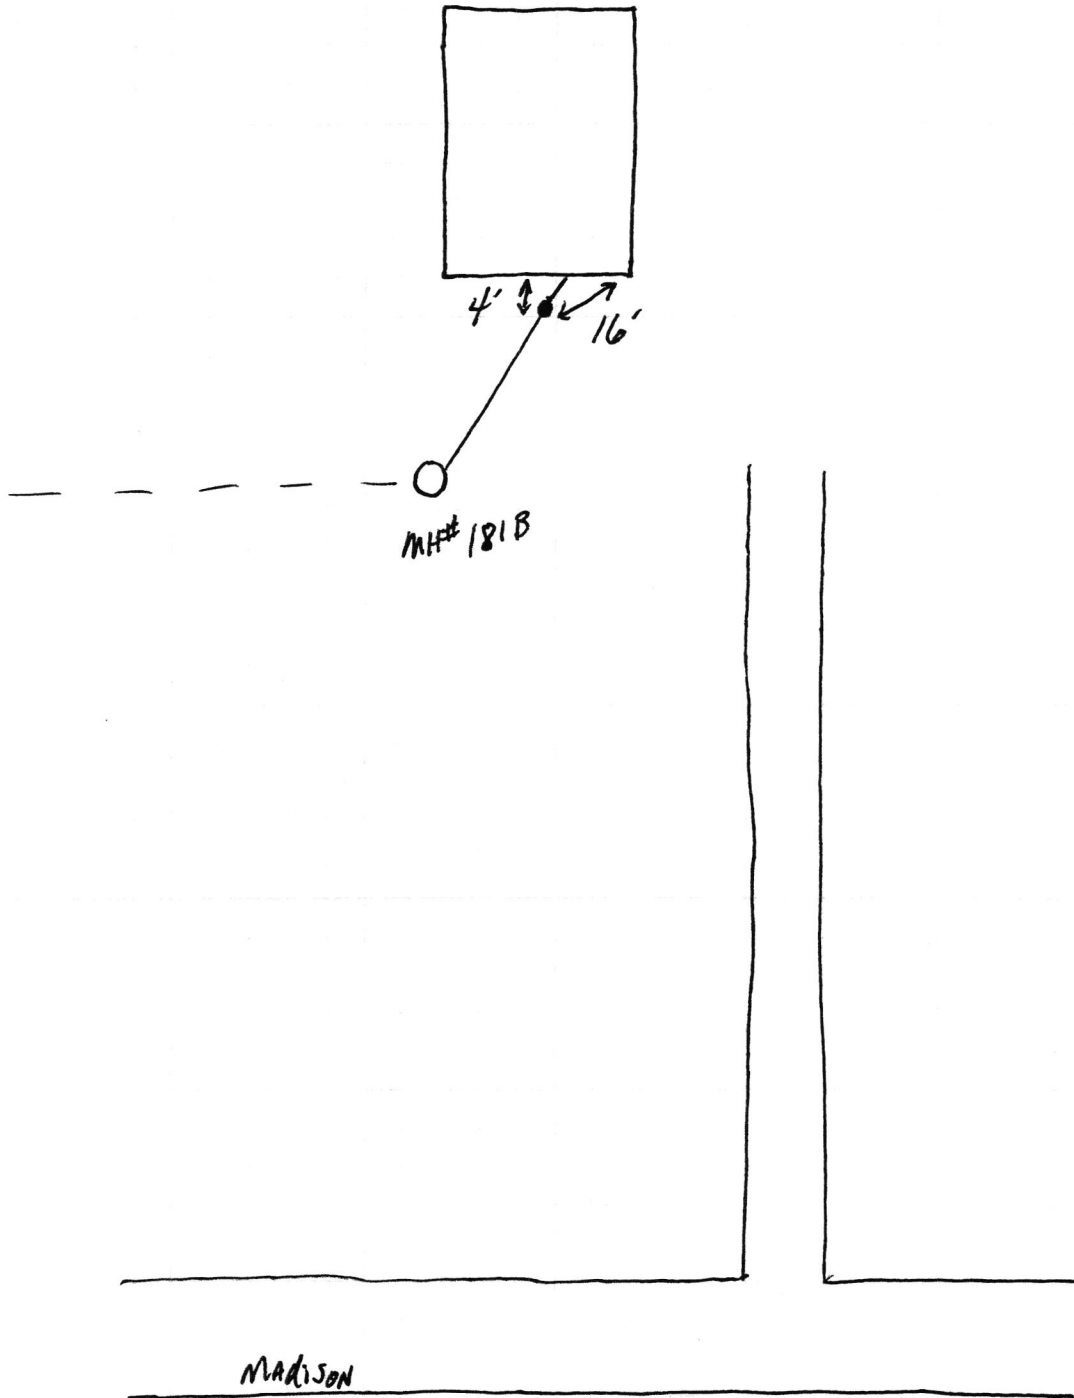

419-4a1 E Madison

SRP Phase II

6/11/18

