

Gidw.

PROJECT Phase II

SHEET _____ OF _____


SUBJECT _____

DATE 3-9-18

JOB NO. 4447

BY ALIAS

419 Franklin

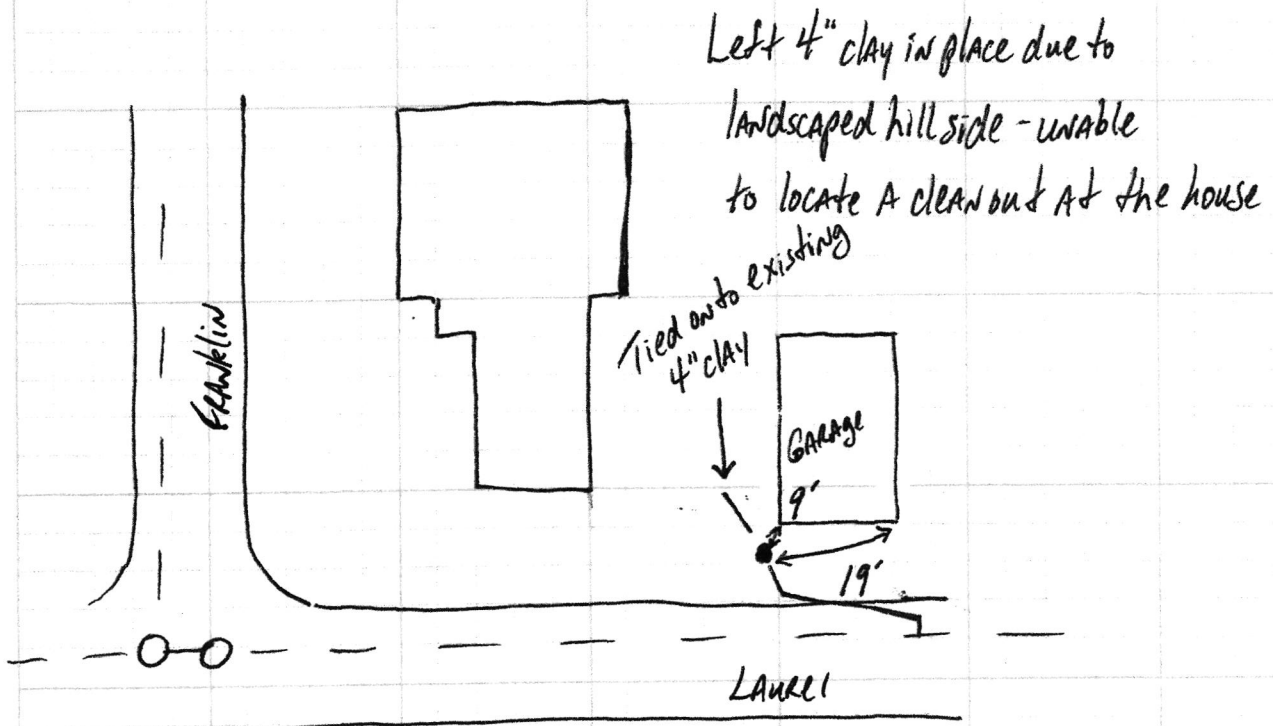

419 Franklin

SRP Phase II

