




PROJECT Phase II SHEET _____ OF _____

SUBJECT _____ DATE 4-26-18

JOB NO. 4447

BY Atlas

419 W. State

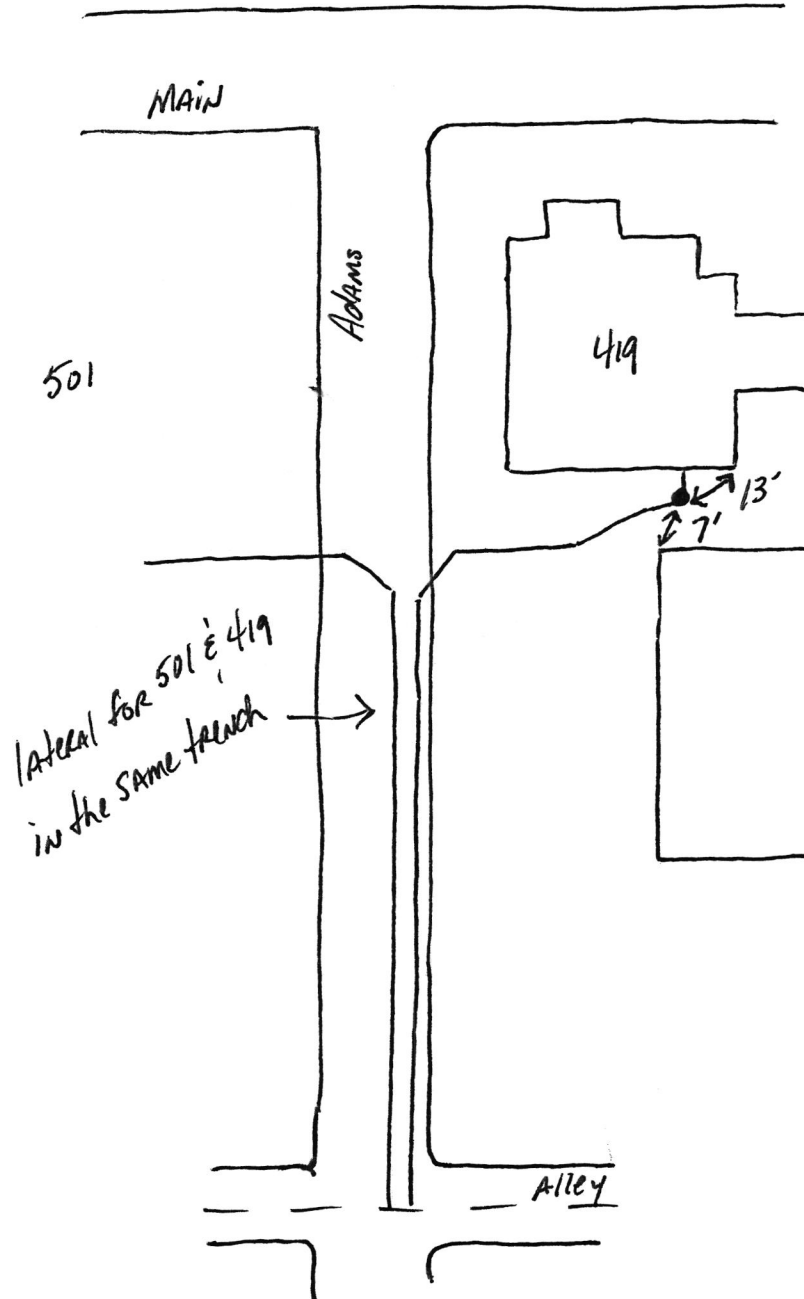

4/9 w state

SRF
Phase II

5.3.18

