

Gidw.


PROJECT Phase II SHEET _____ OF _____

SUBJECT _____ DATE 3-2-18

JOB NO. 4447

BY Atlas

420 S. Franklin

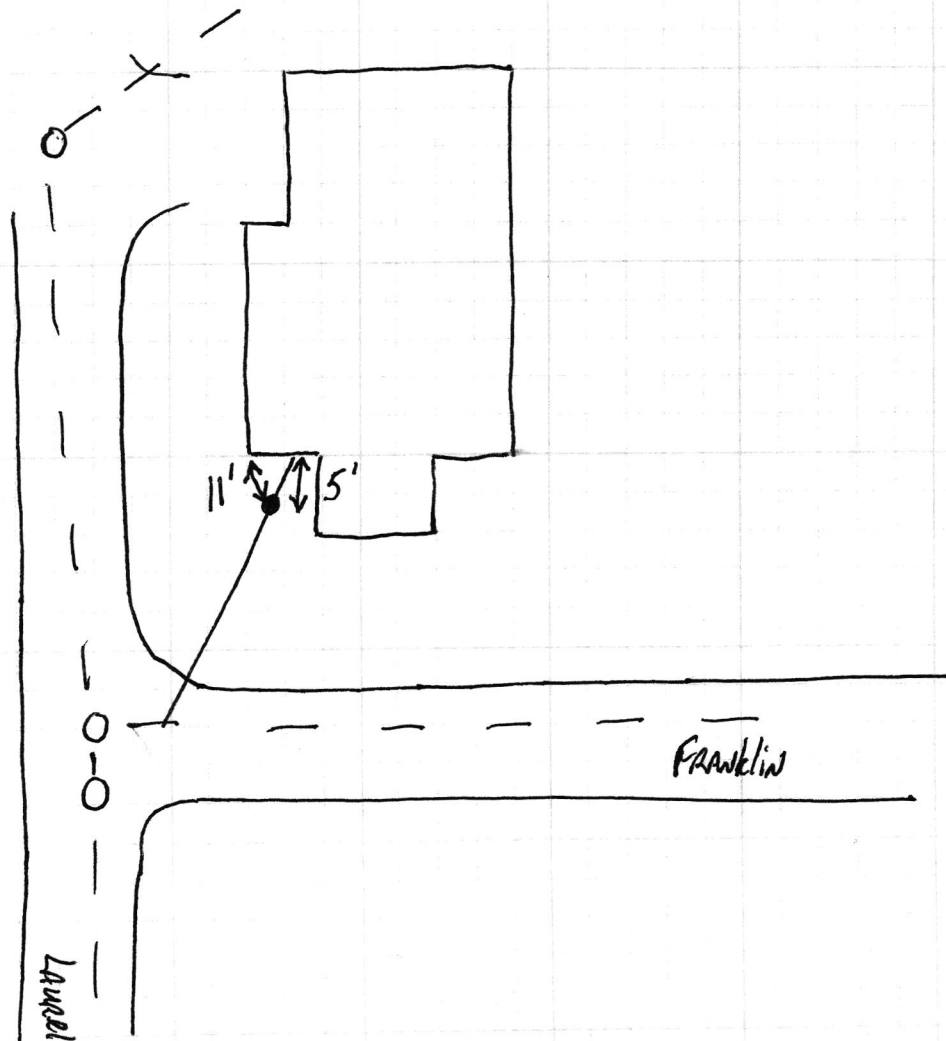

420 S Franklin

SRP Phase II

