


Gidw.

PROJECT Phase II SHEET _____ OF _____

SUBJECT _____ DATE 3-13-18

JOB NO. 4447

BY Atlas

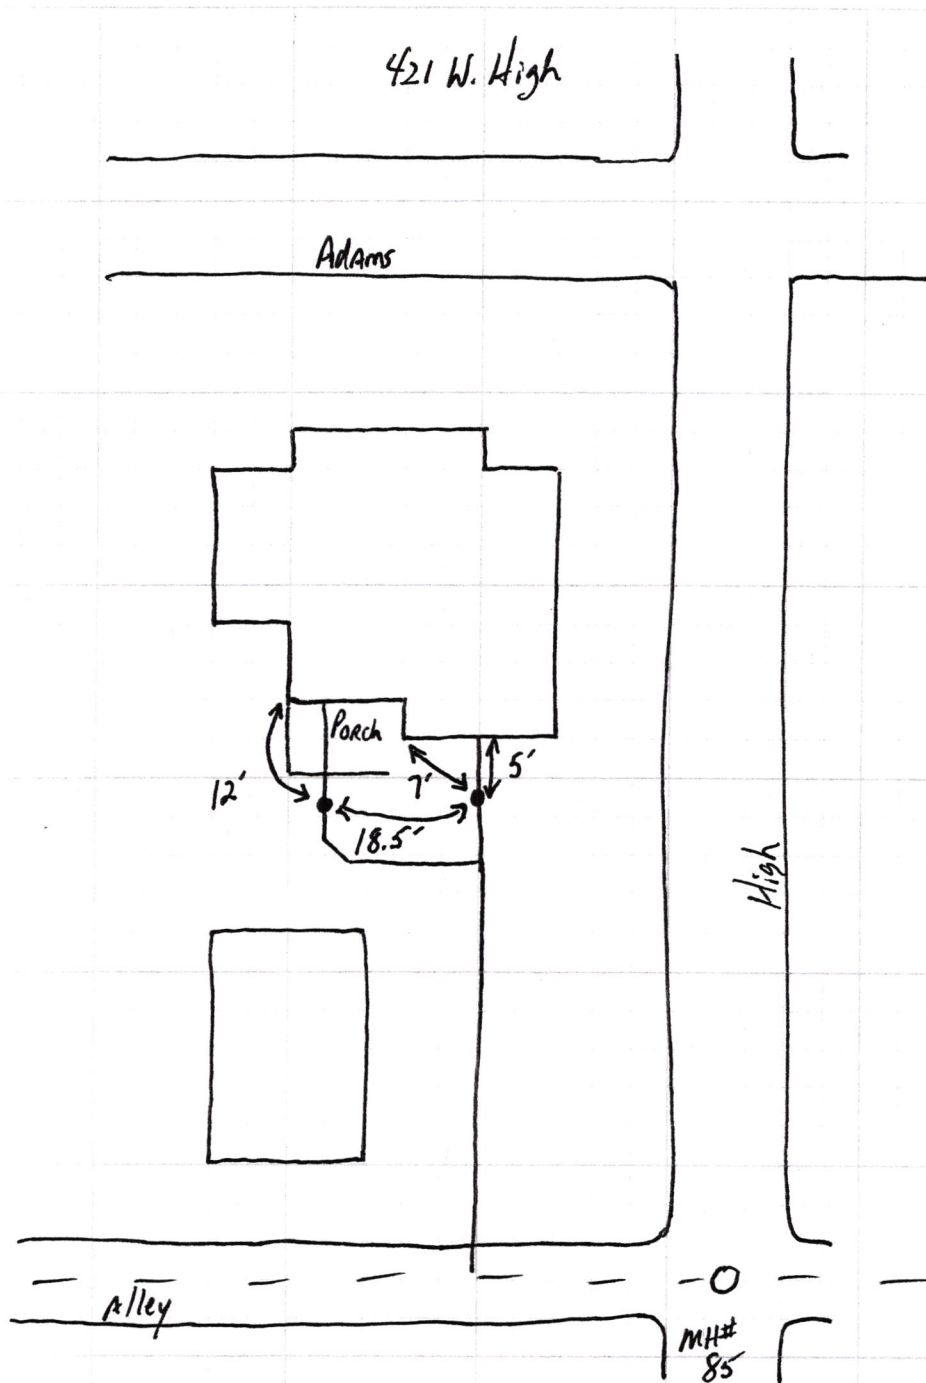

Replacement

421 W. High


SRF Phase II

8.22.18



421 W High

SPR Phase III

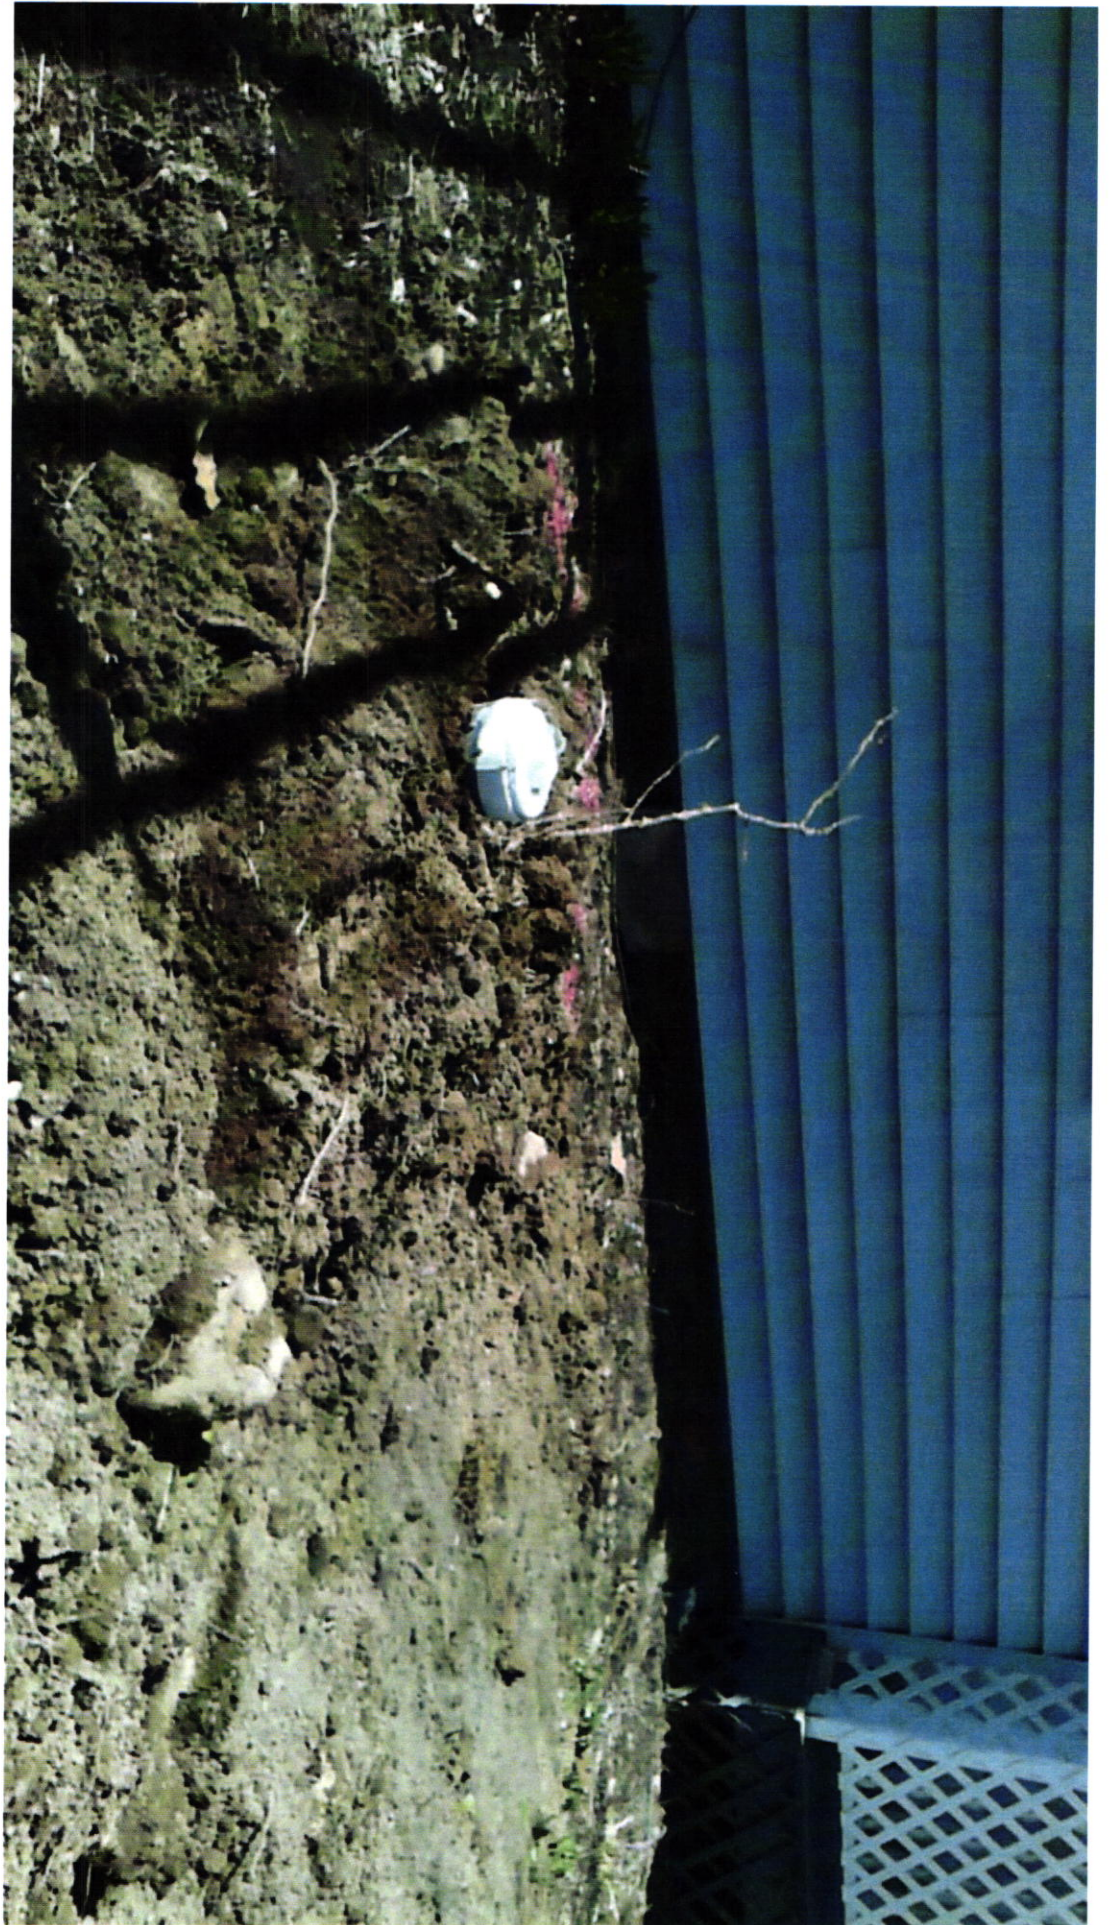

Gidw.

PROJECT Phase II

SHEET _____ OF _____

SUBJECT _____

DATE 3-13-18

JOB NO. 4447

BY Atlas

