


Gidw.

PROJECT Phase II SHEET _____ OF _____
SUBJECT _____ DATE 6-8-18
JOB NO. 4447
BY Atlas

423/ 425 E. Madison

↑
N

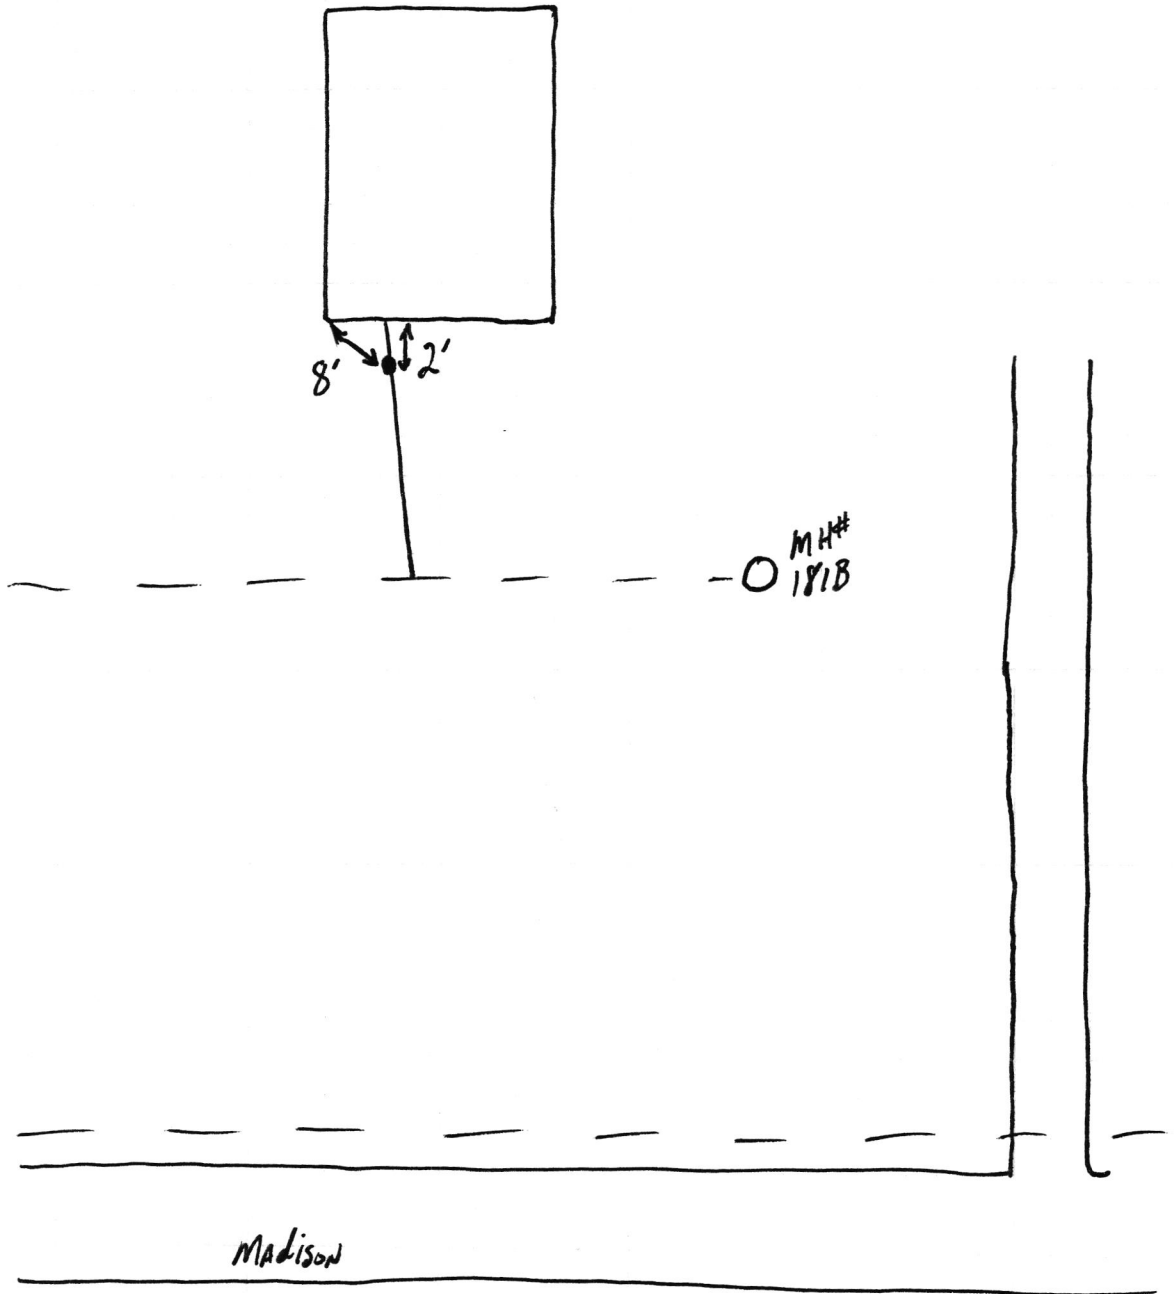

4a3-4b5 & Madison

SPT Phase II

6.11.18

