

GLW

PROJECT

Phase II

SHEET _____ OF _____

SUBJECT


DATE 7-25-18

JOB NO. 4447

BY ATLAS

424 E State

↑
N

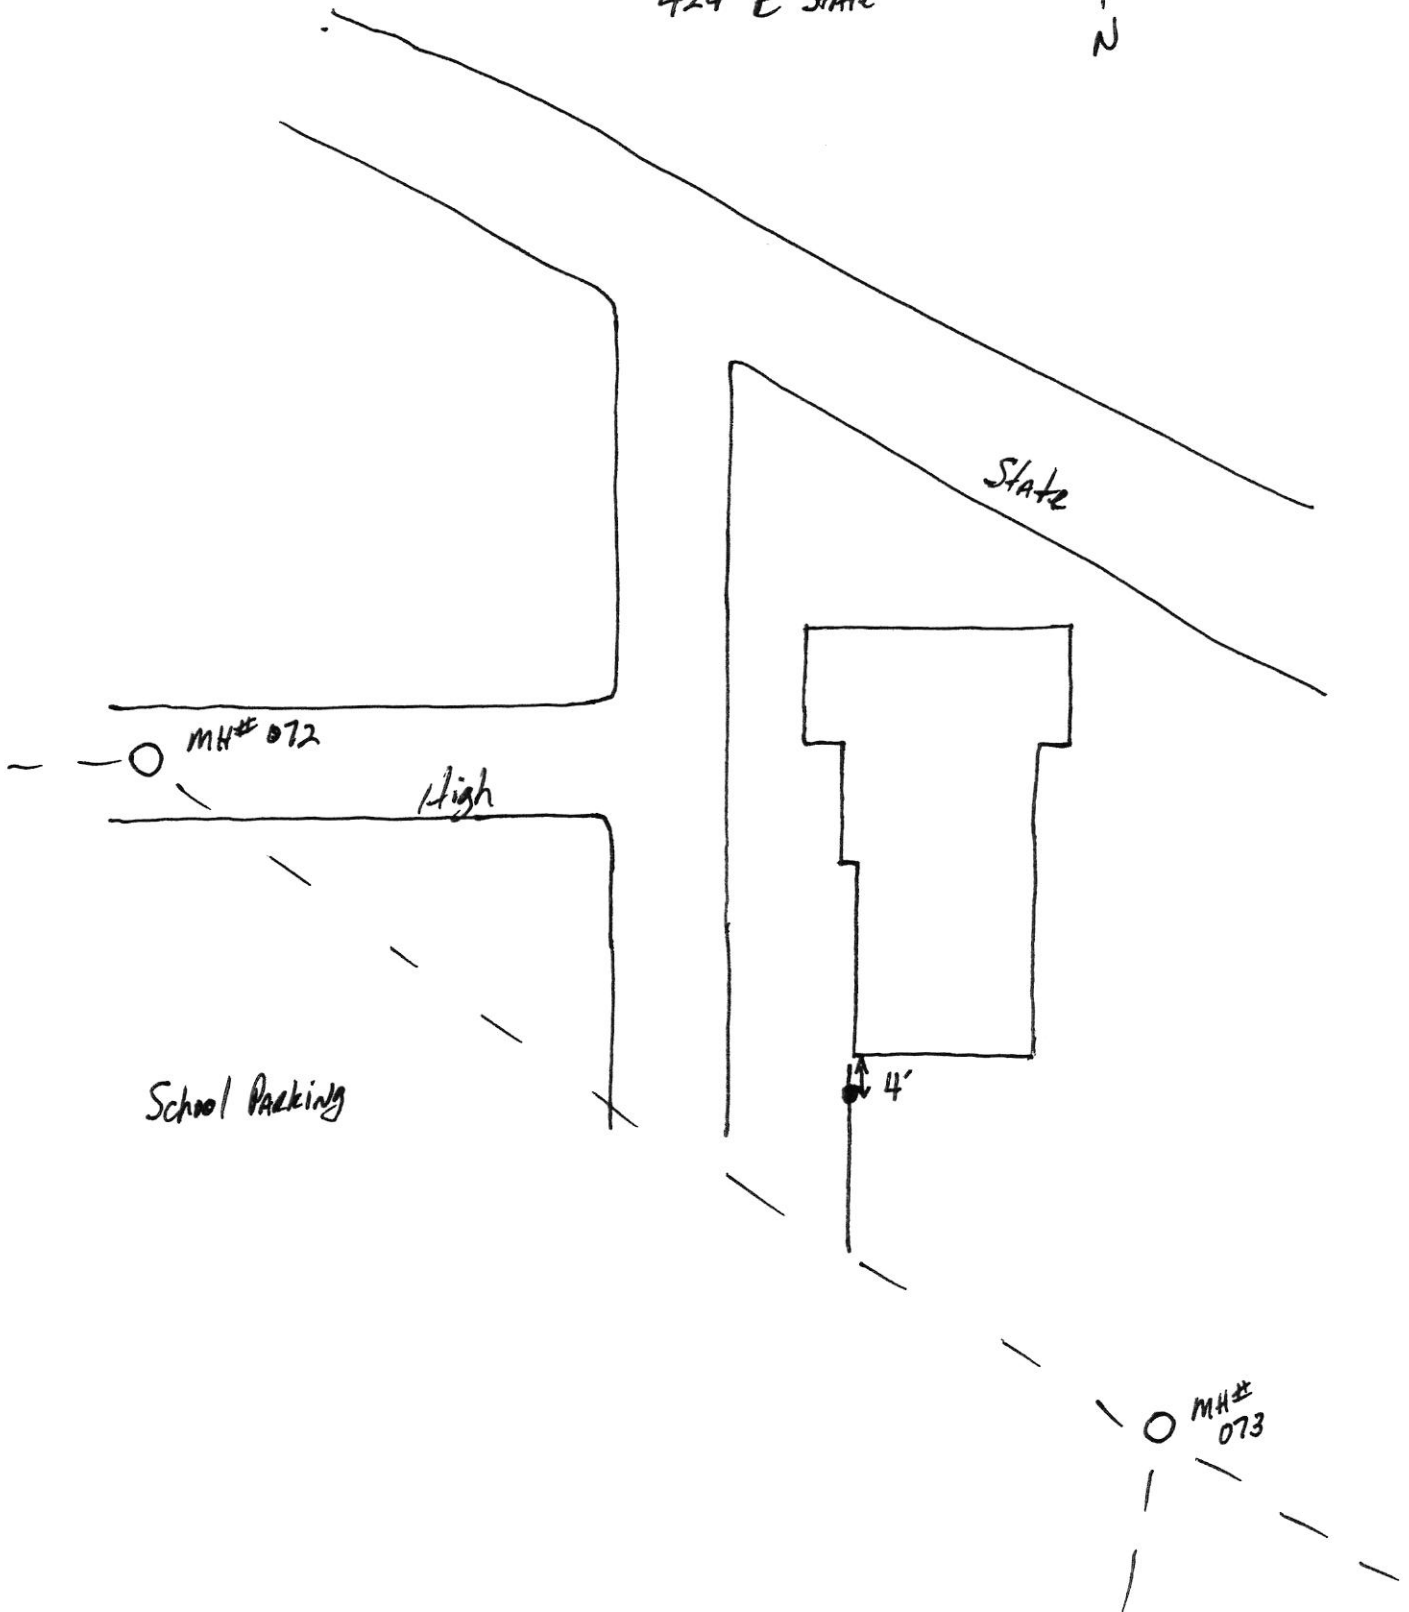

404 E State

S&F Phase II

7.30.18

