

22-23325.00
4500

FALL CREEK REGIONAL WASTE DISTRICT
9378 S 650 WEST, P.O. BOX 59, PENDLETON, IN 46064
765-778-7544

AGREEMENT FOR SANITARY SEWER SERVICE

This Agreement made and entered into this 26th day of April, 2001, between FALL CREEK REGIONAL WASTE DISTRICT ("District") and Terry Young ("Applicant") regarding the provision of sanitary sewer service, and the assignment of capacity in, and connection to, the District's facilities for the premises located at 430 E US 36, Pendleton.

NOW THEREFORE, the parties, in consideration of the mutual promises set out in this Agreement, the receipt and sufficiency of which is hereby acknowledged, agree as follows:

1. The Applicant agrees that all workmanship and materials shall conform to all District ordinances and the District's construction standards. District must accept and approve all work and materials before backfilling and final connection is made to the sewer mains. Any violation of this provision will cause all lines and appurtenances in violation to be removed and replaced at the Applicant's expense.
2. The District shall have the right to enter upon the Applicant's premises at all reasonable times to inspect, repair, or replace any equipment used in connection with the District's service or which has an impact on said service.
3. The Applicant shall be responsible for all monthly user rates, capacity charges, and tap fees. The failure to pay any rate charge or fee may result in a lien against the property and/or the termination of service to the property, the cost of which will be borne by Applicant, including, but not limited to, all attorney's fees and collection costs.
4. The District shall not be responsible for any damages as a result of any failure to supply service unless said damages are due to default, neglect or culpability on the part of the District.
5. If there is an available sanitary sewer within three hundred (300) feet of the property line, the property owner shall be required to connect to the District's sanitary sewer system.
6. The Applicant and District agree that the provision of sanitary sewer service touches and concerns the property and the terms of this Agreement bind the District and Applicant and their heirs, executors, administrators, personal representatives, successors, agents, attorneys, assigns, designees, and transferees.

The parties hereto have read and fully understand the above provisions and agree to comply with said provisions.

FALL CREEK REGIONAL WASTE DISTRICT	APPLICANT
_____ Signature	_____ Signature

STATE OF INDIANA)
) SS:
COUNTY OF MADISON)

SUBSCRIBED and sworn to before me this _____ day of _____, 200__.


My Commission Expires: _____	Signature _____
	Printed _____
	Notary Public
	Resident of Madison County

INSPECTOR Re DATE INSPECTED 6-6-1 APPROVED ✓ REJECTED _____

REASON FOR REJECTION _____

DATE REINSPECTED _____ APPROVED _____ REJECTED _____

NOTES:
SIZE PIPE 4" TYPE PIPE PVC
BASEMENT YES X NO _____
SUMP PUMP YES _____ NO X
DOWNSPOUT TO GROUND YES X NO _____ Labels
SEPTIC TANK PUMPED & FILLED YES _____ NO _____
CONTRACTOR GERRY
SPECIAL CONDITIONS _____
EXISTING HOME X
NEW CONSTRUCTION _____

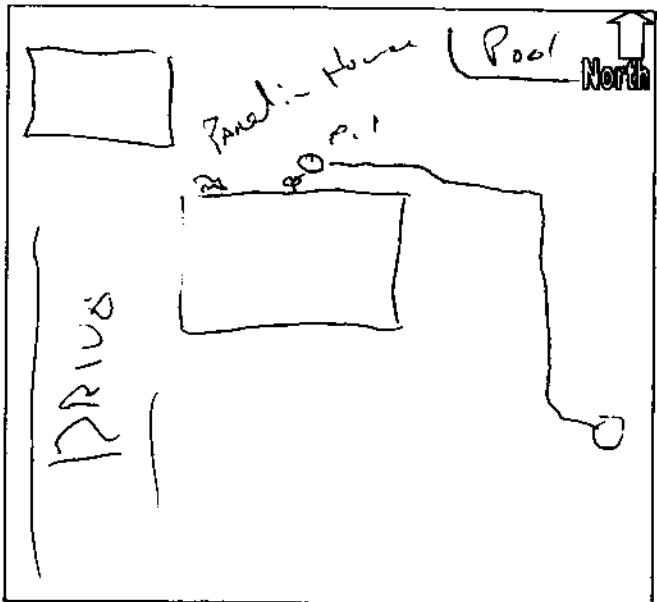

TERRY L. YOUNG
430 E. US 36
PENDLETON, INDIANA 46064

1002

Date 4-23-01

71-330/749
21

Pay to the Order of Full Creek Regional Waste District \$ 2,731.⁰⁰/₁₀₀

Two Thousand Seven hundred and thirty One + ⁰⁰/₁₀₀ Dollars



UNION BANK
CHESTERFIELD, INDIANA
MEMBER F.D.I.C.

For Tape fees
⑆074904308⑆

Terry L. Young
1002



GERRY'S CONSTRUCTION SERVICE

TIN#35-2048835
4424 E. 575 S.
MARKLEVILLE, IN 46056
(765) 779-4269

4502

71-553/749
BRANCH 1

DATE


4/30/01

PAY
TO THE
ORDER OF

Fall Creek Regional Waste

one thousand twenty four dollars and $\frac{80}{100}$

\$ 1024 ⁸⁰

DOLLARS  Security features
included
Details on back



Madison
Community Bank

FOR

Terry Young - grinder

Sandy Kreslin

⑈004502⑈ ⑆074905539⑆