

GLW



PROJECT Phase II SHEET _____ OF _____

SUBJECT _____ DATE 7-25-18

JOB NO. 4447

BY Atlas


432 E. State

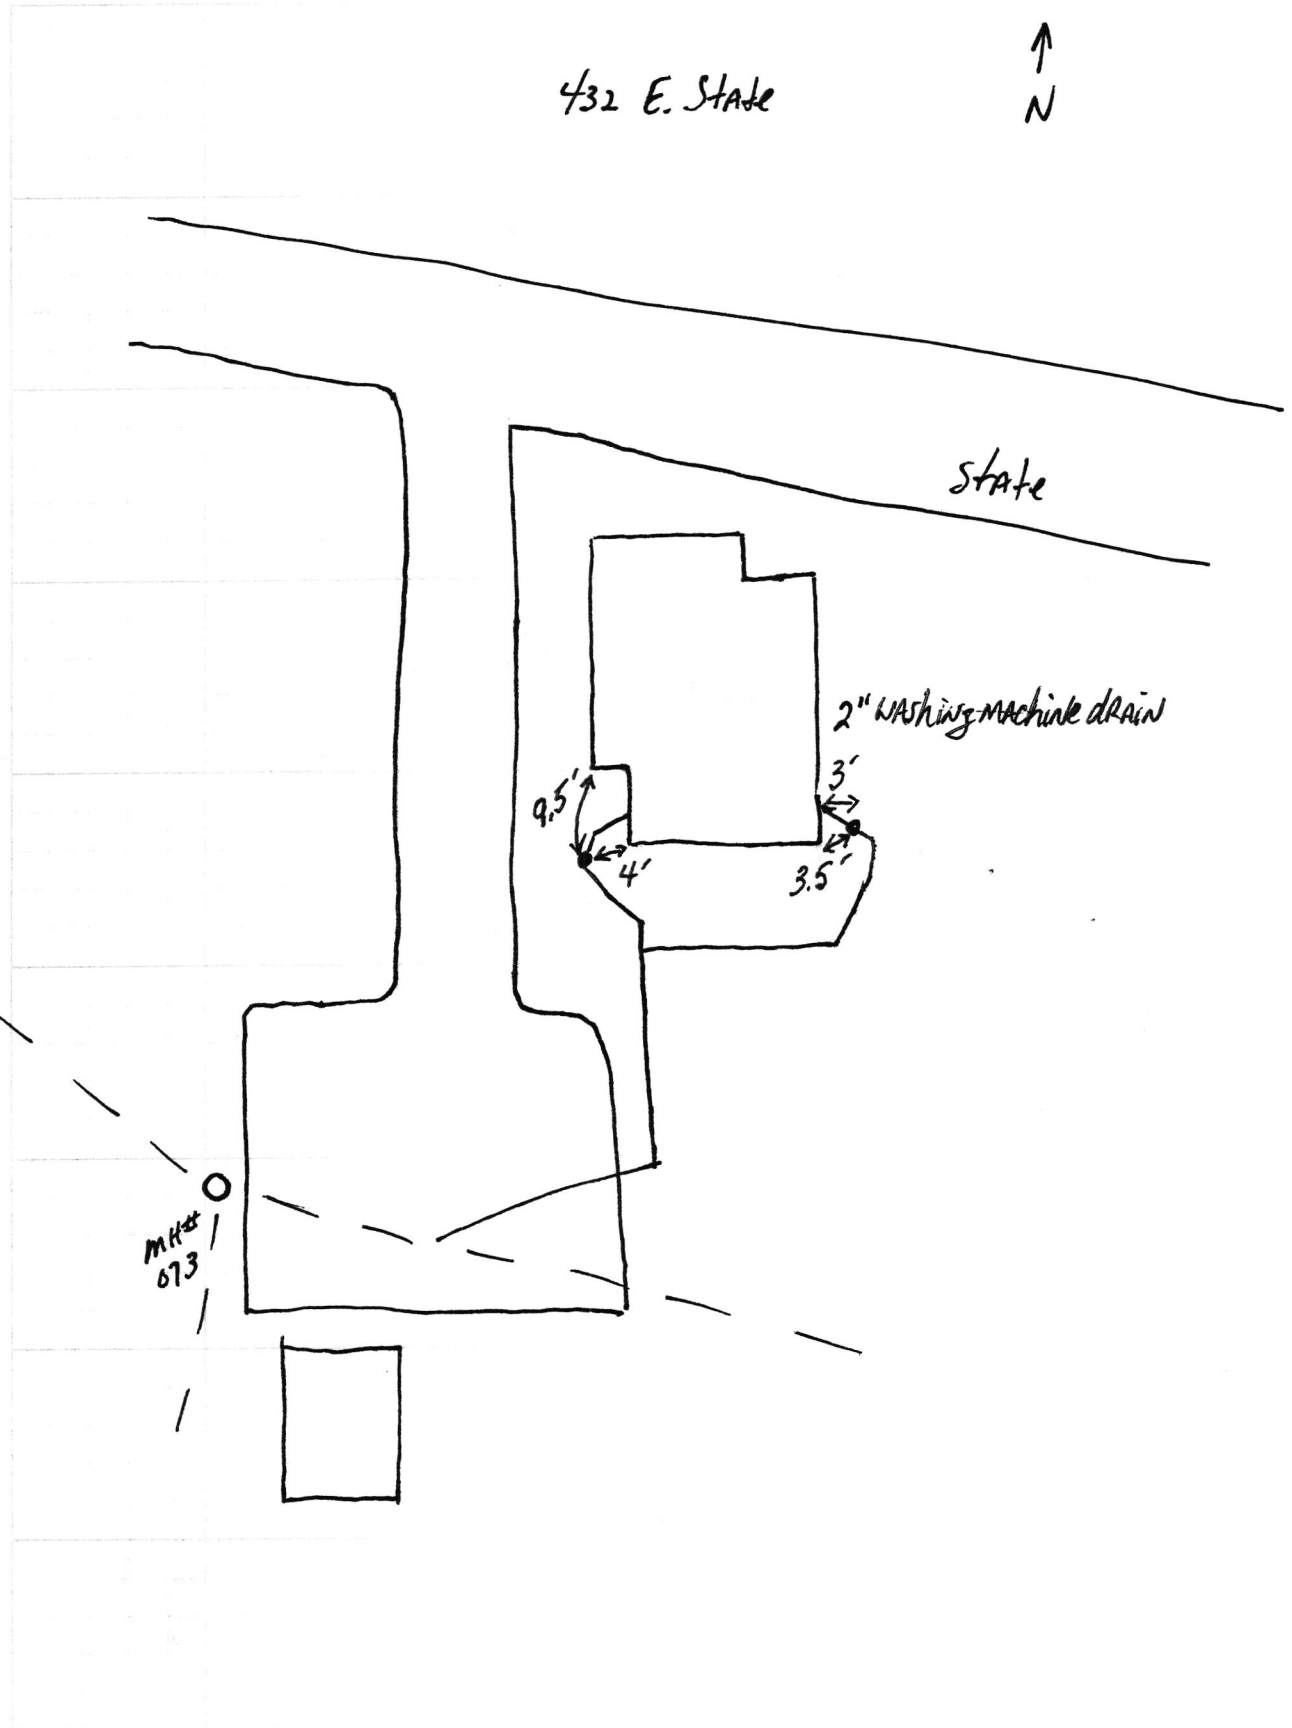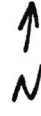

43a E State

Sgt phase II

7.30.18

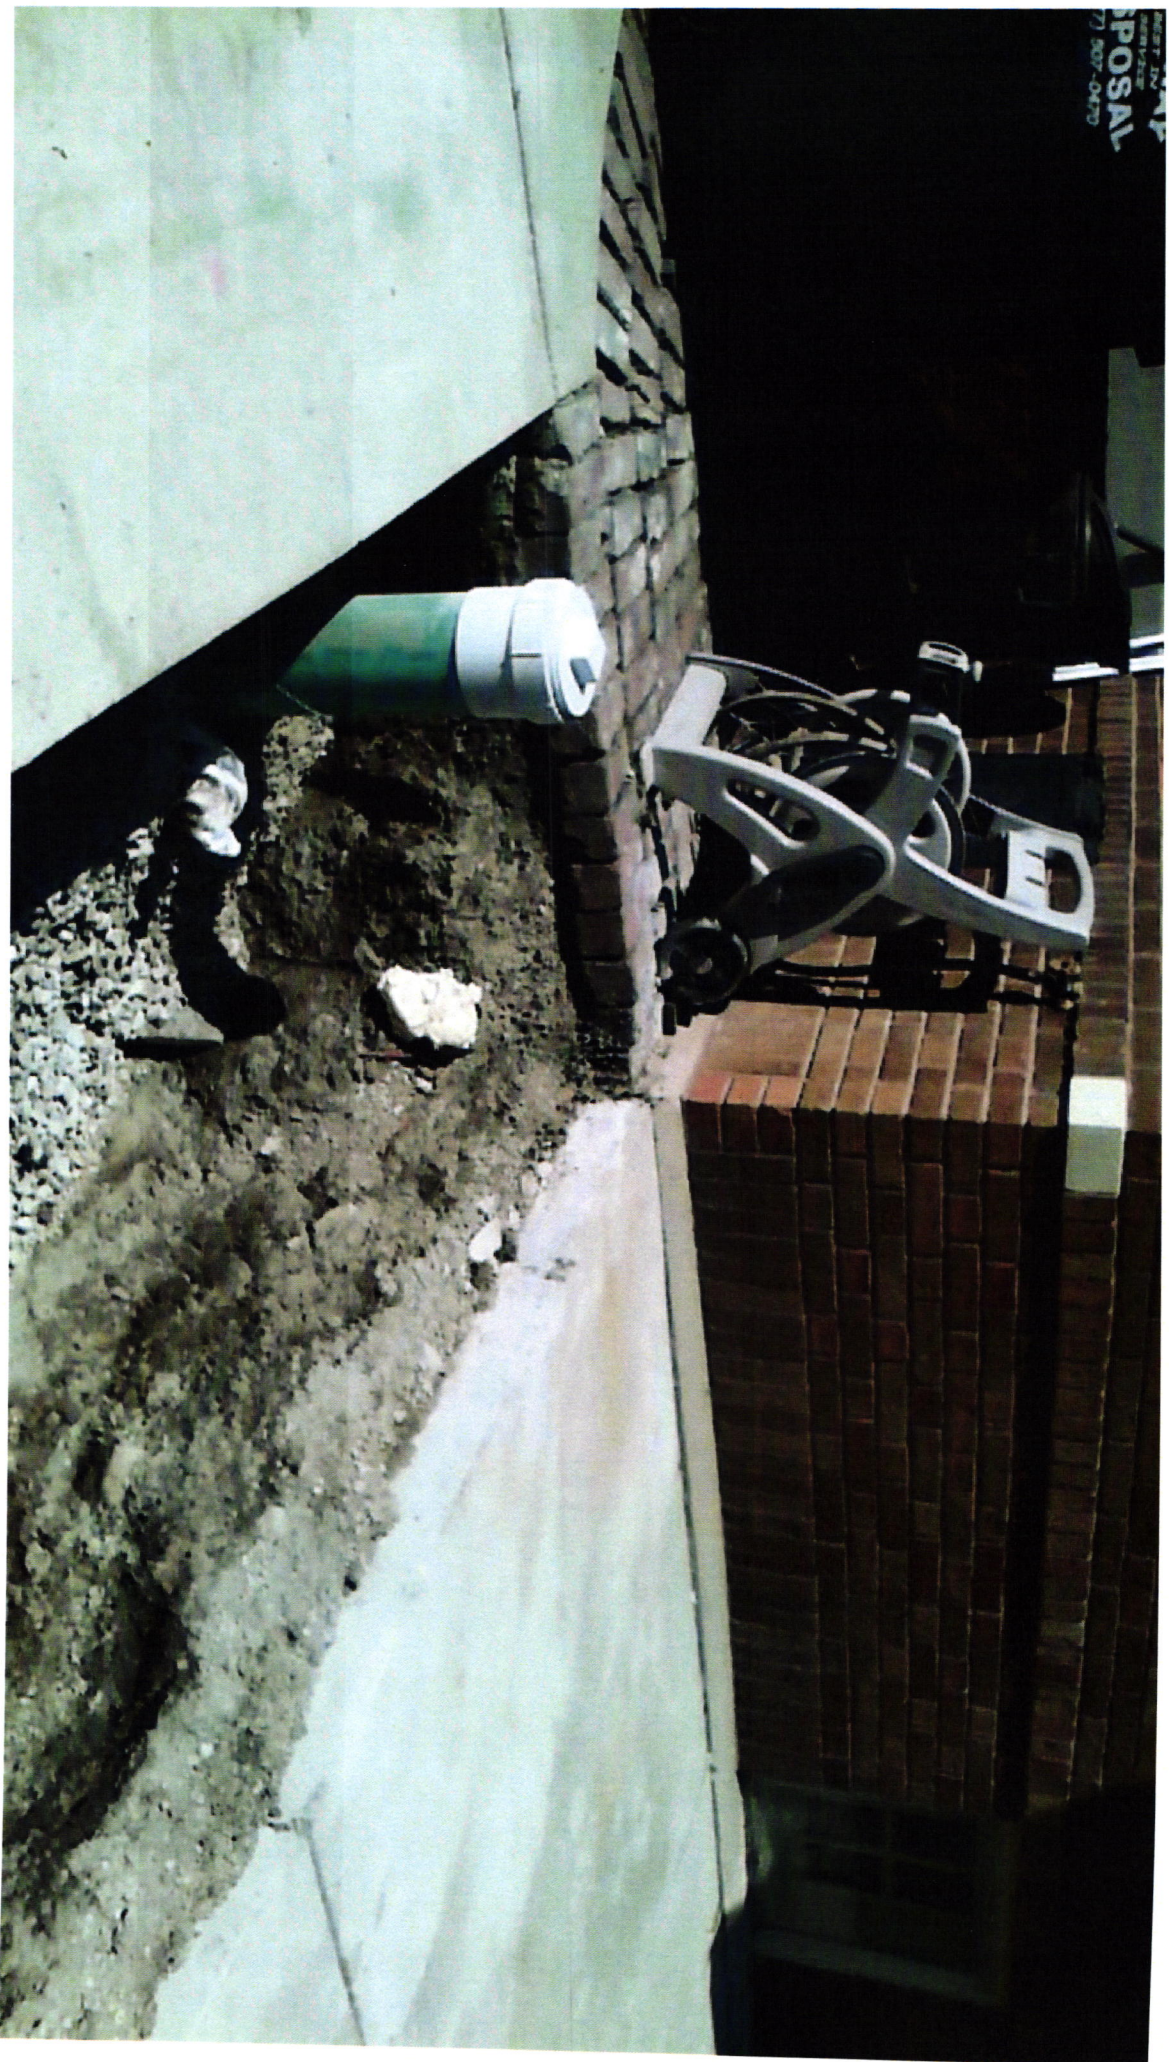

43a E State

SRP Phase II

7-30-18

