

Gidw.

PROJECT Phase II

SHEET _____ OF _____


SUBJECT _____

DATE 12-13-11

JOB NO. 4447

BY Atlas

433 S. MAIN

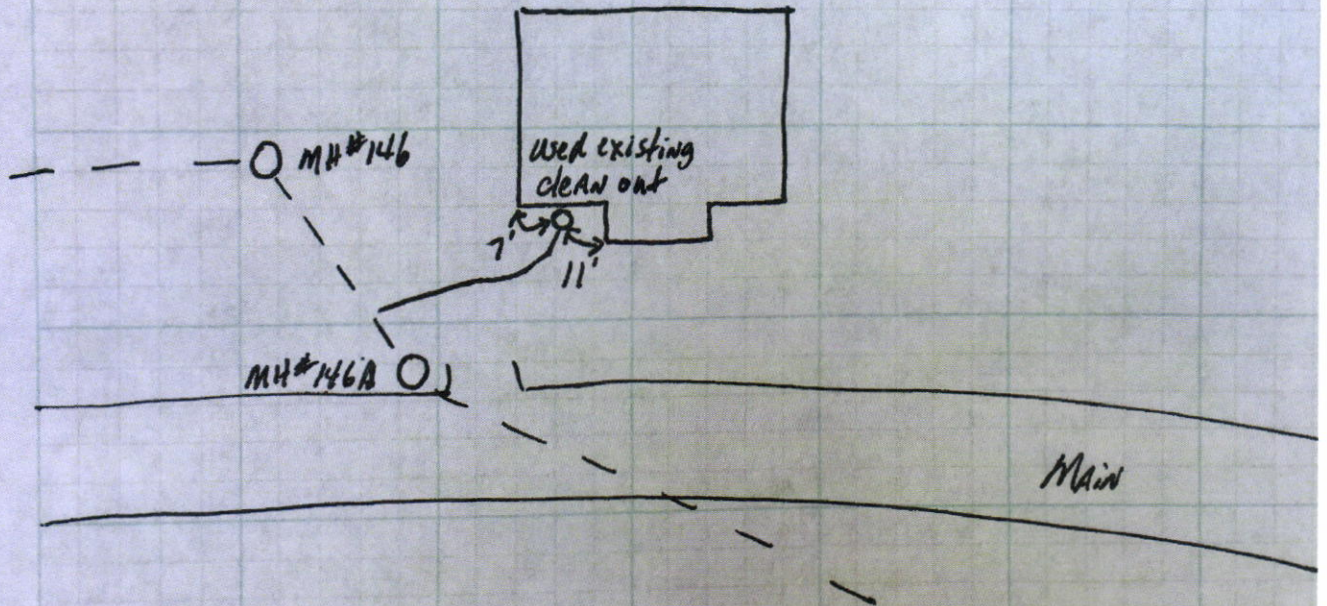

433 S Main ST

Lateral replacement

SRF Phase II
Dec '17

