

FALL CREEK REGIONAL WASTE DISTRICT Delles


Box 44, Pendleton, Indiana 46064

1-0002716.00

APPL	ICATION FOR SEWER PERMIT
Permit No.	Date
Permit Void 90 days from	Date of Issuance
Owner Name Karl	C. Clark,
Property Address	436 n. Huston
Lot #	P.O. BOX PO BOX 82
Town Ingales	, IN Zip Code 46048
Phone 485-4	437/ Water Meter 100 "
\$ 150 00 Tap	on Fee Paid pd. 8-14-85
\$ 25.00 Insp	ection fee paid
All workmanship and : District Ordinance as des Acceptance and approval m authorized representative to the main sewer lines.	materials shall conform to the standards of the cribed in Ordinance 84-2 and 84-3 as amended. The constant be made by the District inspector or his duly before backfilling and final connection is made. Any violation of applicable regulations will tenances in violation to be removed and replaced
approval of materials, an	onal Waste District is responsible for the inspection and installation techniques only. All costs for on and any liabilities resulting from same is the ne property owner.
I have read and full comply by said provisions	y understand the above provisions and agree to
	APPLICANT(S) SIGNATURE
*******	***********
1 3 4	INSPECTOR
Date inspected 4-64	Approved Rejected

Reason for rejection Date reinspected Size Pipe Type Pipe Basement Yes Sump Pump Yes Downspout to Ground Yes X No Septic Tank Pumped & filled Yes No Contractor FLAT FORD

Special Conditions

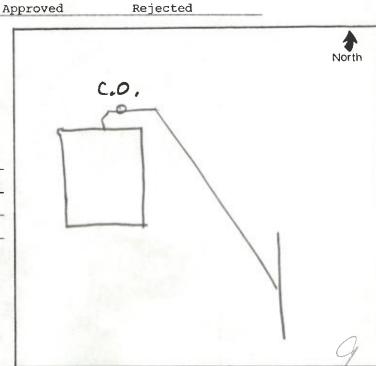

F TOMORROW DO SEA OF SECTION INCIDENCE OF THE DISTRICT DIMENSION DO SEA OF SECTION INCIDENCE OF THE DISTRICT DIMENSION DO SEA OF SECTION OF THE DISTRICT DIMENSION DO SEA OF SECTION DE SEA OF S

THE OWNERS IN

1 200

AND THE RESERVE THE PARTY OF TH

X

on the land

6.217

NOT THE