



# FALL CREEK REGIONAL WASTE DISTRICT

Box 44, Pendleton, Indiana 46064

22-21080.00

2-0021080

Nº 000427

## APPLICATION FOR SEWER PERMIT

Permit No. \_\_\_\_\_ Date 10/28/85

Permit Void 90 days from Date of Issuance

Owner Name Harry Brooks

Property Address RR 2 Box 65 9105 Lantern Meadows

Lot # \_\_\_\_\_ P.O. Box 4450 Rt. 900 S.

Town Pendleton, IN Zip Code 46064-9509

Phone 778-3387 Water Meter \_\_\_\_\_

\$ 150.00 Tap on Fee Paid

\$ 25.00 Inspection fee paid

Application is hereby made for connection to the Fall Creek Regional Waste District Sewer System for the above listed property - Permit Type: Residential ☒, Commercial \_\_\_\_\_, Industrial \_\_\_\_\_, or Governmental/Institutional \_\_\_\_\_. User Information \_\_\_\_\_.

All workmanship and materials shall conform to the standards of the District Ordinance as described in Ordinance 84-2 and 84-3 as amended. Acceptance and approval must be made by the District inspector or his duly authorized representative before backfilling and final connection is made to the main sewer lines. Any violation of applicable regulations will cause all lines and appurtenances in violation to be removed and replaced at the owners expense.

The Fall Creek Regional Waste District is responsible for the inspection, approval of materials, and installation techniques only. All costs for materials and installation and any liabilities resulting from same is the sole responsibility of the property owner.

I have read and fully understand the above provisions and agree to comply by said provisions.

X Harold H. Brooks

APPLICANT(S) SIGNATURE

\*\*\*\*\*

INSPECTOR Tim

Date inspected 11-6-85 Approved ☒ Rejected \_\_\_\_\_

Reason for rejection \_\_\_\_\_

Date reinspected \_\_\_\_\_ Approved \_\_\_\_\_ Rejected \_\_\_\_\_

### Notes:

Size Pipe 6"

Type Pipe PVC

Basement Yes \_\_\_\_\_ No ☒


Sump Pump Yes \_\_\_\_\_ No ☒

Downspout to Ground Yes ☒ No \_\_\_\_\_

Septic Tank Pumped & filled Yes ☒ No \_\_\_\_\_

Contractor Perrin

Special Conditions \_\_\_\_\_

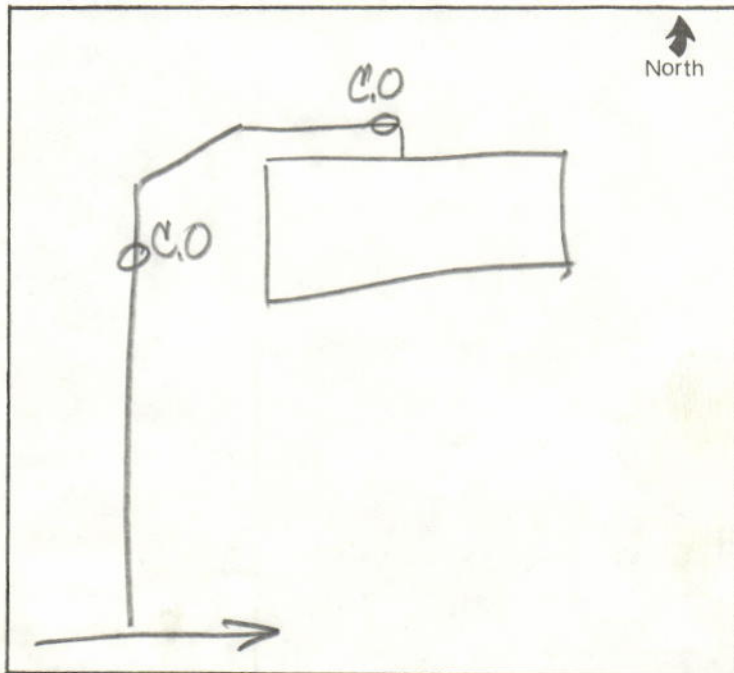

15A