

Fall Creek Regional Waste District

9378 S 650 W, P.O. Box 59, Pendleton, IN 46064

765-778-7544

Agreement for Sanitary Sewer Service

#6778

This Agreement made and entered into this 7 day of Dec, 2018, between Fall Creek Regional Waste District ("District") and Martin Builders ("Applicant") regarding the provision of sanitary sewer service, and the assignment of capacity in and connection to, the District's facilities for the premises located at #44 P.P.

Street Address: 448 Janis Ave Pendleton, IN 46064

Now therefore, the parties, in consideration of the mutual promises set out in this Agreement, the receipt and sufficiency of which is hereby acknowledged, agree as follows:

1. The Applicant agrees that all workmanship and materials shall conform to all District ordinances and the District's construction standards. District must accept and approve all work and materials before backfilling and final connection is made to the sewer mains. Any violation of this provision will cause all lines and appurtenances in violation to be removed and replaced at the Applicant's expense.
2. The District shall have the right to enter upon the Applicant's premises at all reasonable times to inspect, repair, or replace any equipment used in connection with the District's service or which has an impact on said service.
3. The Applicant shall be responsible for all monthly user rates, capacity charges, and tap fees. The failure to pay any rate charge or fee may result in a lien against the property and/or the termination of service to the property, the cost of which will be borne by Applicant, including, but not limited to, all attorney's fees and collection costs.
4. The District shall not be responsible for any damages as a result of any failure to supply service unless said damages are due to default, neglect or culpability on the part of the District.
5. If there is an available sanitary sewer within three hundred (300) feet of the property line, the property owner shall be required to connect to the District's sanitary sewer system.
6. The Applicant and District agree that the provision of sanitary sewer service touches and concerns the property and the terms of this Agreement bind the District and Applicant and their heirs, executors, administrators, personal representatives, successors, agents, attorneys, assigns, designees, and transferees.

The parties hereto have read and fully understand the above provisions and agree to comply with said provisions.

FALL CREEK REGIONAL WASTE DISTRICT

Signature


APPLICANT

Signature

STATE OF INDIANA)
) SS:
COUNTY OF MADISON)

SUBSCRIBED and sworn to before me this 7 day of Dec, 2018

My Commission Expires:

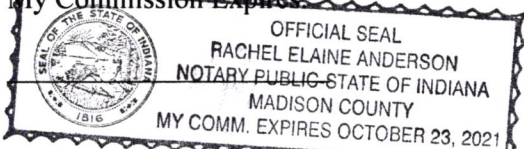

Signature

Printed

Notary Public

Resident of Madison County

Inspector SN Date Inspected 2/15/19 Approved — Rejected —

Reason for Rejection —

Date Reinspected — Approved — Rejected —

Notes:

Size Pipe 6" Type Pipe 35

Basement Yes — No —

Sump Pump Yes — No —

Downspout to Ground Yes — No —


Septic Tank Pumped & Filled Yes — No —

Contractor Bolton Ex.

Special Conditions —

Existing Home —

New Construction ✓

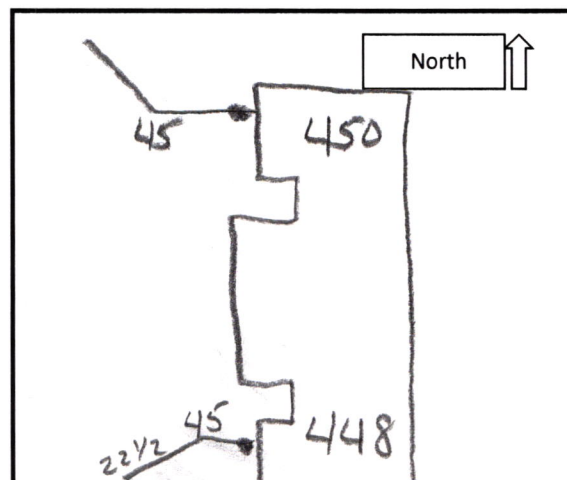

2 Pictures attached

448 Janis Rendle Point #44

Steve N 2-15-19




448 Janis

Pende Point #44

Steve N

8.15.19



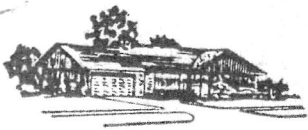

MUSTIN BUILDERS, INC.
810 CENTRAL AVENUE
ANDERSON, IN 46012
PH. 765-644-8502


STAR
Financial Bank
PO Box 11409 • Fort Wayne, IN 46858-1409

306092

71-167/749

Pay: *****Six thousand seven hundred forty dollars and no cents

DATE

CHECK NO.


AMOUNT

December 6, 2018

306092 \$*****6,740.00

PAY
TO THE
ORDER
OF

Fall Creek Waste Management
P. O. Box 59
Pendleton, IN 46064-0059

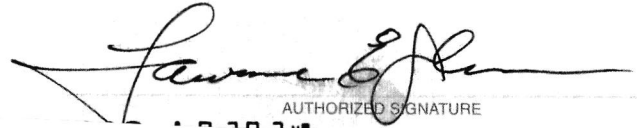
AUTHORIZED SIGNATURE

MP

rec #010860