

Gidw.


PROJECT Phase II SHEET _____ OF _____

SUBJECT _____ DATE 8-10-18

JOB NO. 4447

BY Atlas

459 E. Water

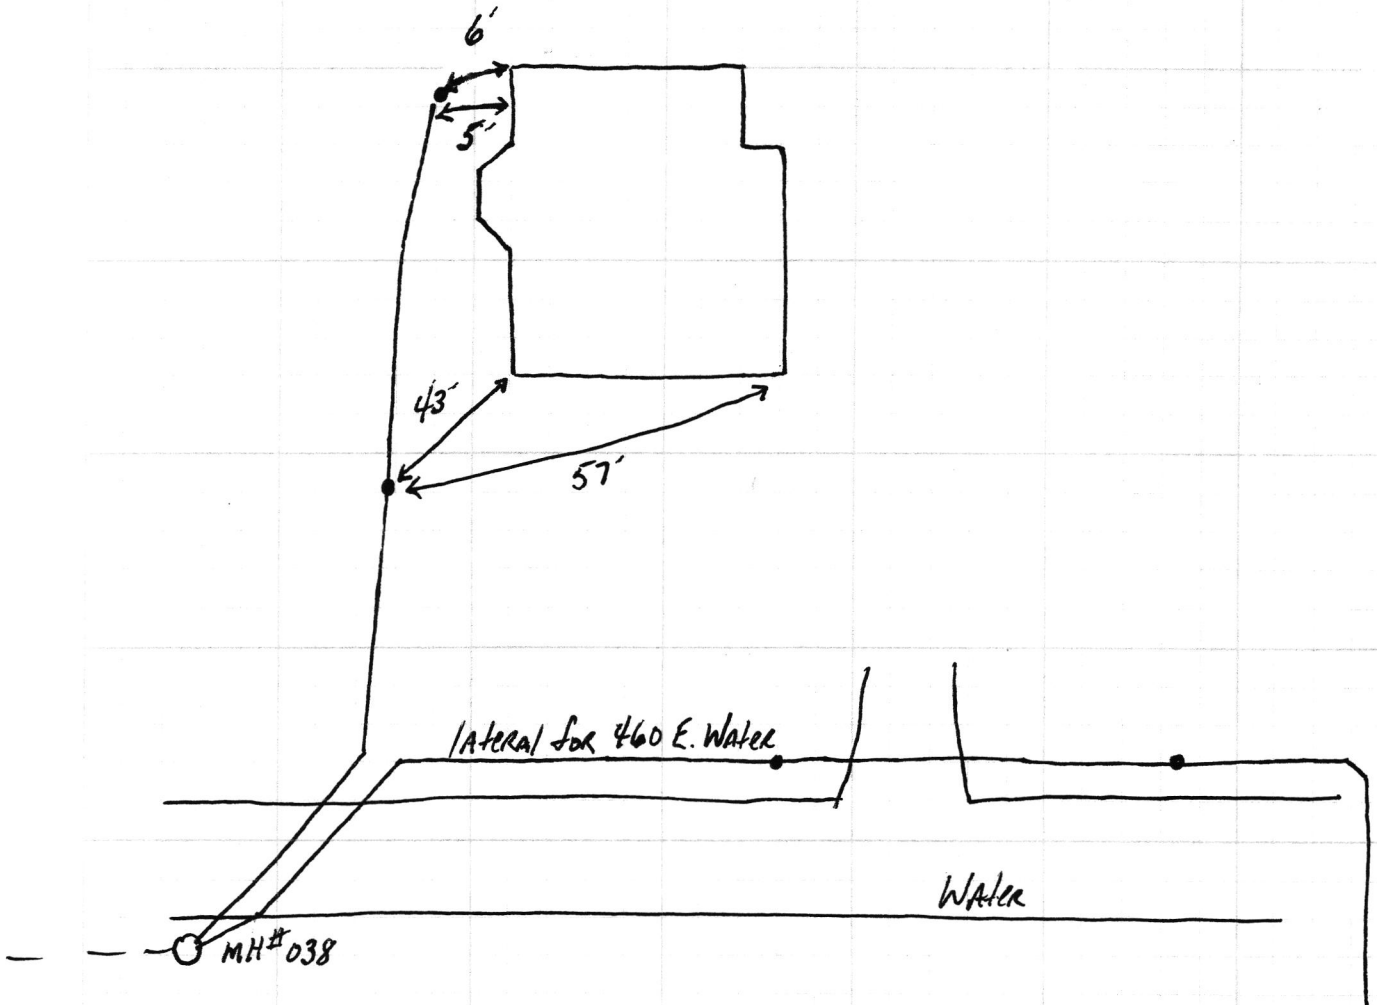

701 C water

S&E Phase II

8-15-18





OK phase II

8.15.18