
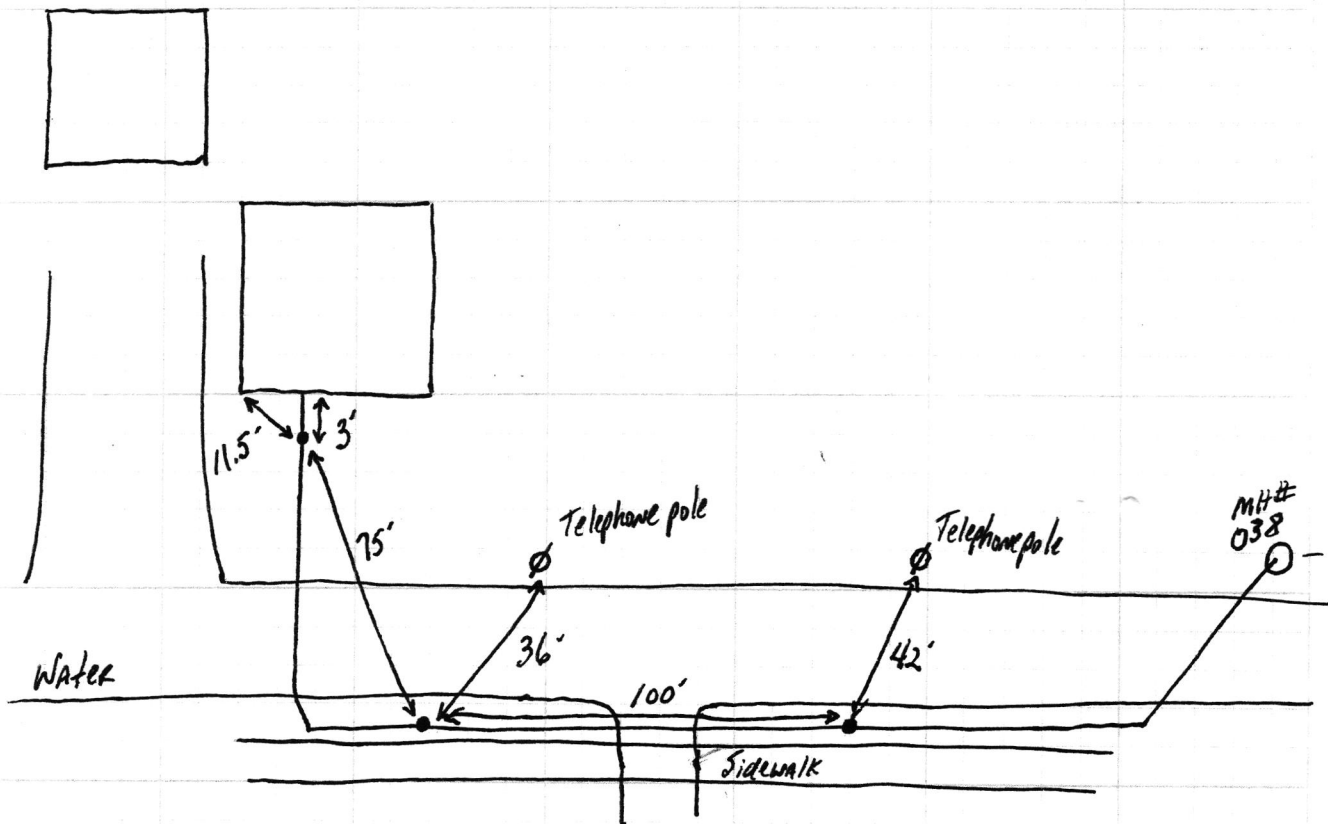


Gidw.

PROJECT Phase II SHEET _____ OF _____
SUBJECT _____ DATE 8-9-18
JOB NO 4447
BY AHAS

460 E. Water

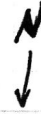

SRT Phase II

8.15.18



new water

SKT Phase II

8.15.18





OK phase II

8.15.18