
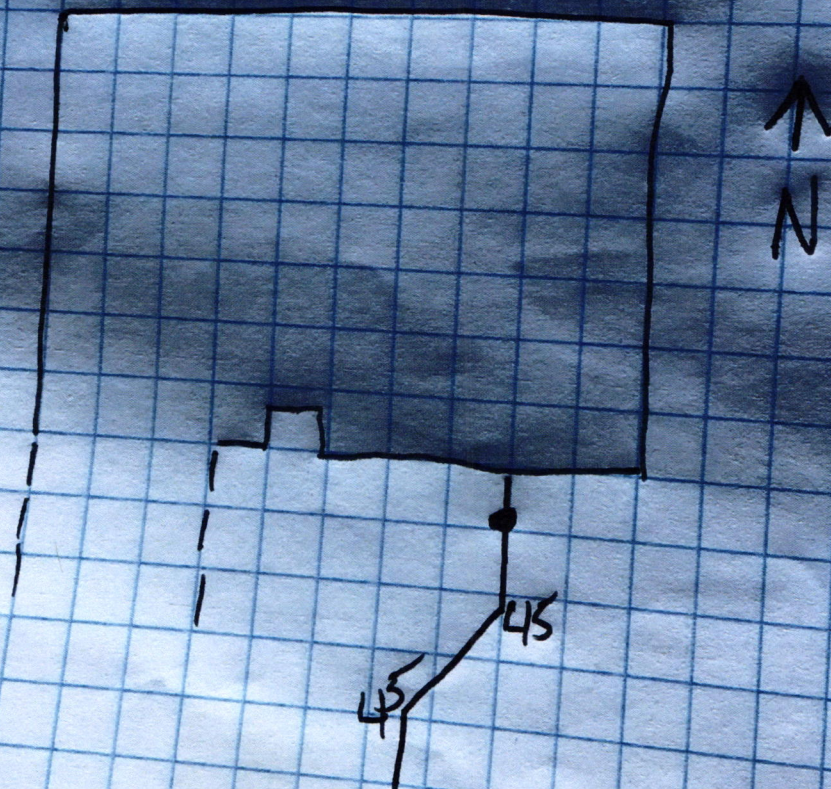


North 

Drawing
+
1 picture
attached

Falls @ Pendleton
Lot 3
464 Cayuga Dr.
5/20/22 P.R. Watson





FALL CREEK REGIONAL WASTE DISTRI
9378 S 650 W
PO BOX 59
PENDLETON, IN 46064
765-778-7544

FALL CREEK REGIONAL WASTE DIST

Date: 12/02/2021 10:18:06 AM

CREDIT CARD SALE

VISA
CARD NUMBER: *****5166 K

TOTAL AMOUNT: \$31,472.00

APPROVAL CD: 042225
RECORD #: 000
CLERK ID: Becca
CUST CODE: fees
SALES TAX: \$0.00
INVOICE #: Falls of Pendleton Fees

Thank you for your payment!

Customer Copy

Receipt # 11964

Falls of Pendleton Fees

Tap Fees: 11 lots x \$760.00 = \$8360.00

Lots: 3, 6, 8, 17, 22, 34, 35, 46, 50, 51, 55

Grinder Units: 6 Lots x \$3852.00 = \$23112.00

Lots: 17, 22, 46, 50, 51, 55

units \$ 21600.00
tax \$ 1512.00