

G.R.W.

PROJECT Phase II SHEET _____ OF _____

SUBJECT _____ DATE 2-28-18

JOB NO. 4447

BY Atlas


464 E. State

MH# 74




20'

2'

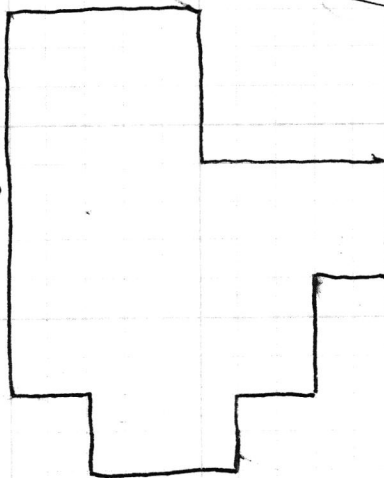

State

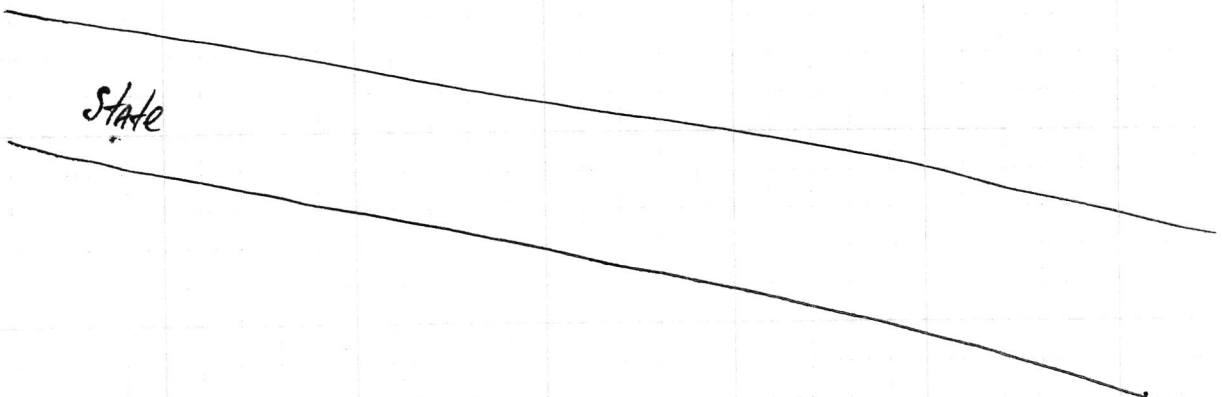

4604 E State ST

SRP Phase II

