


Gidw.

PROJECT Phase II SHEET \_\_\_\_\_ OF \_\_\_\_\_  
SUBJECT \_\_\_\_\_ DATE 7-23-18  
JOB NO. 4447  
BY Atlas

470 E. State

↑  
N

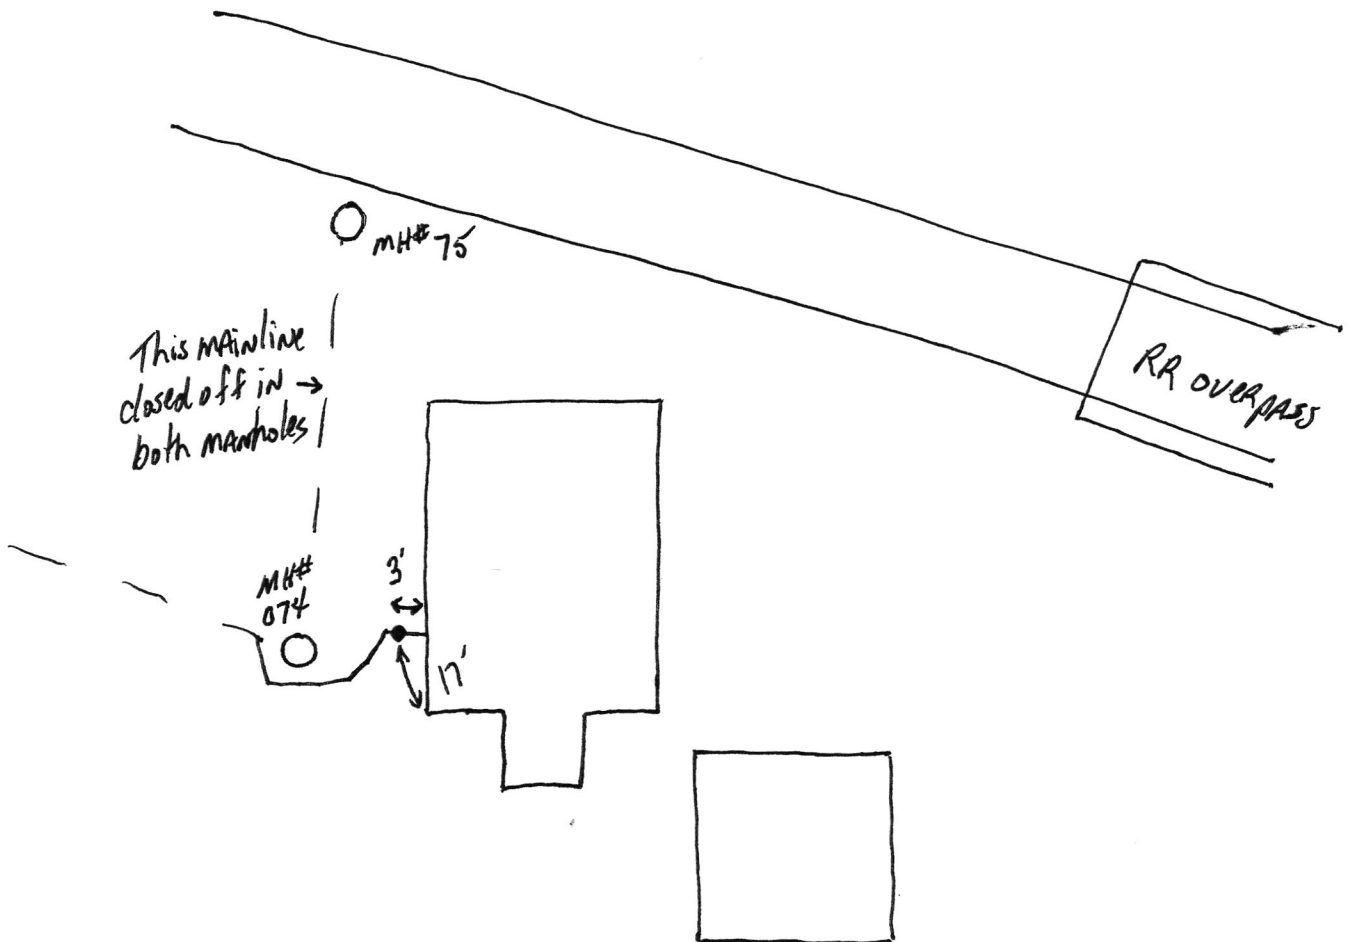

470 E State

SRC Phase II

7.30.18

