

Gidw.

PROJECT Phase II SHEET _____ OF _____


SUBJECT _____ DATE 6-5-18

JOB NO 4447

BY AHLB

471 E. Madison

↑
N

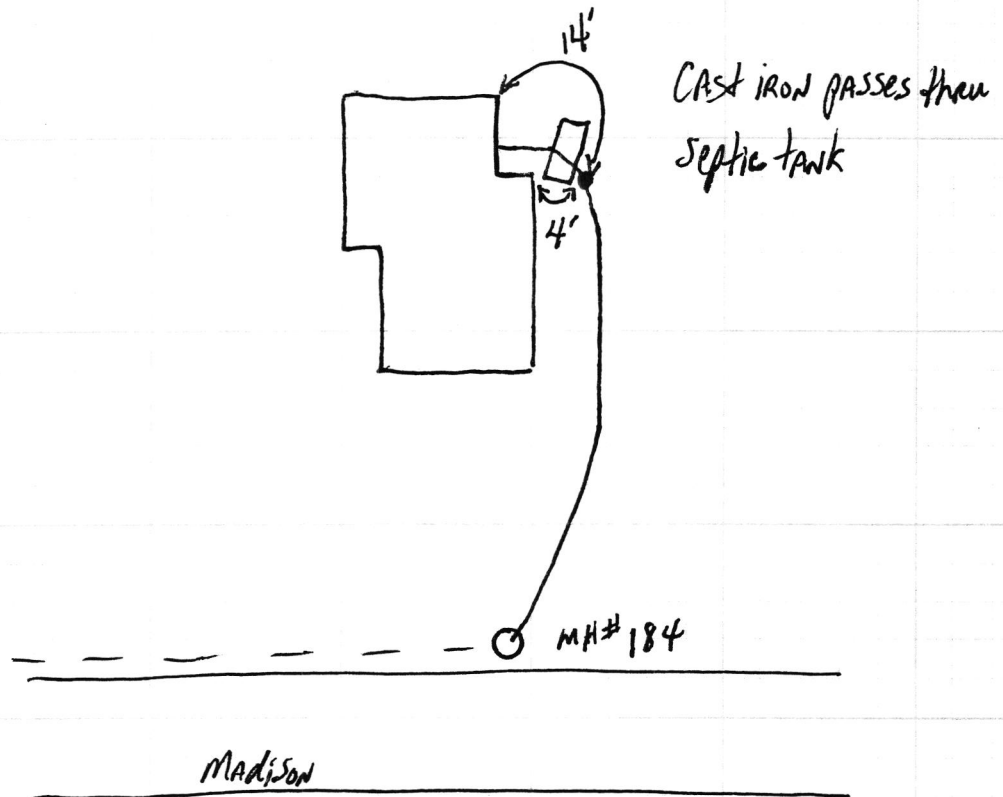

471 E Madison

SRF Phase II

6.11.18

