
#6668

Fall Creek Regional Waste District 9378 S 650 W, P.O. Box 59, Pendleton, IN 46064 765-778-7544

# **Agreement for Sanitary Sewer Service**

This Agreement made and entered into this day of day of Regional Waste District ("District") and Coronado provision of sanitary sewer service, and the assignment of capac facilities for the premises located at Falls of Pendleton Lot 2	ity in and connection to, the District's
Street Address: 482 CAYUGA DR	
<b>Now therefore,</b> the parties, in consideration of the mutual promises set out in this Agreement, the receipt and sufficiency of which is hereby acknowledged, agree as follows:	
<ol> <li>The Applicant agrees that all workmanship and materials shall conform to all District ordinances and the District's construction standards. District must accept and approve all work and materials before backfilling and final connection is made to the sewer mains. Any violation of this provision will cause all lines and appurtenances in violation to be removed and replaced at the Applicant's expense.</li> <li>The District shall have the right to enter upon the Applicant's premises at all reasonable times to inspect, repair, or replace any equipment used in connection with the District's service or which has an impact on said service.</li> <li>The Applicant shall be responsible for all monthly user rates, capacity charges, and tap fees. The failure to pay any rate charge or fee may result in a lien against the property and/or the termination of service to the property, the cost of which will be borne by Applicant, including, but not limited to, all attorney's fees and collection costs.</li> <li>The District shall not be responsible for any damages as a result of any failure to supply service unless said damages are due to default, neglect or culpability on the part of the District.</li> <li>If there is an available sanitary sewer within three hundred (300) feet of the property line, the property owner shall be required to connect to the District's sanitary sewer system.</li> <li>The Applicant and District agree that the provision of sanitary sewer service touches and concerns the property and the terms of this Agreement bind the District and Applicant and their heirs, executors, administrators, personal representatives, successors, agents, attorneys, assigns, designees, and transferees.</li> </ol>	
The parties hereto have read and fully understand the above provisions and agree to comply with said provisions.	
FALL CREEK REGIONAL WASTE DISTRICT Signature	APPLICANT Signature
STATE OF INDIANA ) ) SS: COUNTY OF MADISON )	
SUBSCRIBED and sworn to before me this o day of May, 2001  My Commission Expires:  OFFICIAL SEAL  REBECCA LYNN HUNTER  NOTARY PUBLIC-STATE OF INDIANA  Printed Persecca Lynn Hunter  Printed Persecca Lynn Hunter	
HAMILTON COUNTY MY COMM. EXPIRES NOV 19, 2023 Resident of Hamilton County ************************************	
Inspector Date Inspected H-14-22 Approved Rejected Rejected Reason for Rejected Approved Rejected Reje	
Notes: 61 Type Pipe Puc 35	Kejected
Basement <u>Yes No</u> Sump Pump <u>Yes No</u> Downspout to Ground <u>Yes No</u>	North
Septic Tank Pumped & Filled <u>Yes No</u> Contractor <u>VR WATS ON</u> Special Conditions	Drawing
Existing Home New Construction	1 picture.
	attached



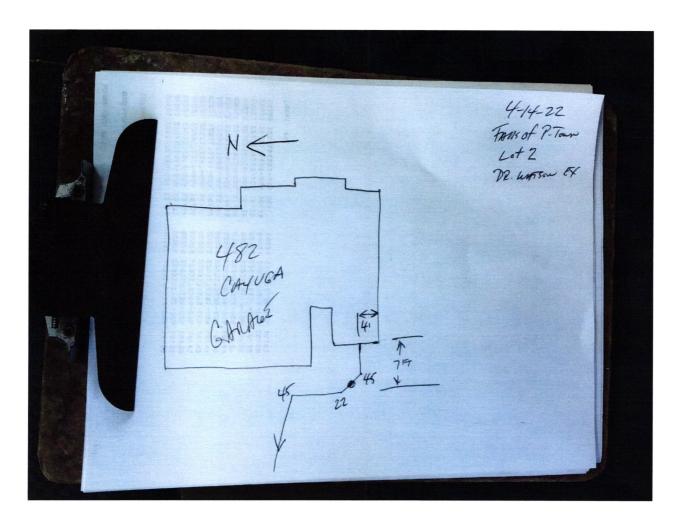

FALL CREEK REGIONAL WASTE DISTRI 9378 S 650 W PO BOX 59 PENDLETON, IN 46064 765-778-7544

FALL CREEK REGIONAL WASTE DIST

Date: 05/06/2021

10:00:27 AM

CREDIT CARD SALE

VISA

CARD NUMBER:

\*\*\*\*\*\*\*\*5166 K

TOTAL AMOUNT:

\$33,331.66

APPROVAL CD:

064394

RECORD #:

000

CLERK ID: CUST CODE: Becca

SALES TAX:

Tap & Grinder

\$0.00

INVOICE #:

21 23 24 25 45

Thank you for your payment!

Customer Copy

## **Tap Fees**

### **Lots Paid**

1 2 5 7 14 18 20 21 23 24 25

\$760.00 x 11 = \$8360.00

# **Grinder Units**

# Lots Paid

18 20 21 23 24 25 45

\$3567.38 x 7 = \$24971.66

Units: \$23338.00

Tax:

\$1633.66

Receipt # 11695