
8-19575.00


#6667

Fall Creek Regional Waste District 9378 S 650 W, P.O. Box 59, Pendleton, IN 46064 765-778-7544

Agreement for Sanitary Sewer Service

This Agreement made and entered into this day of Regional Waste District ("District") and Coronado provision of sanitary sewer service, and the assignment of capa facilities for the premises located at Falls of Pendleton Lot	("Applicant") regarding the acity in and connection to, the District's
Street Address: 498 CAYUGA DRIVE	-
Now therefore, the parties, in consideration of the mutual promises set out in this Agreement, the receipt and sufficiency of which is hereby acknowledged, agree as follows:	
 The Applicant agrees that all workmanship and materials shall conform to all District ordinances and the District's construction standards. District must accept and approve all work and materials before backfilling and final connection is made to the sewer mains. Any violation of this provision will cause all lines and appurtenances in violation to be removed and replaced at the Applicant's expense. 	
2. The District shall have the right to enter upon the Appl inspect, repair, or replace any equipment used in conne has an impact on said service.	icant's premises at all reasonable times to ection with the District's service or which
3. The Applicant shall be responsible for all monthly user rates, capacity charges, and tap fees. The failure to pay any rate charge or fee may result in a lien against the property and/or the termination of service to the property, the cost of which will be borne by Applicant, including, but not limited to, all attorney's fees and collection costs.	
4. The District shall not be responsible for any damages as a result of any failure to supply service unless said damages are due to default, neglect or culpability on the part of the District.5. If there is an available sanitary sewer within three hundred (300) feet of the property line, the	
property owner shall be required to connect to the District's sanitary sewer system. 6. The Applicant and District agree that the provision of sanitary sewer service touches and concerns the property and the terms of this Agreement bind the District and Applicant and their heirs, executors, administrators, personal representatives, successors, agents, attorneys, assigns, designees, and transferees.	
The parties hereto have read and fully understand the above provisions and agree to comply with said provisions.	
FAIL CREEK REGIONAL WASTE DISTRICT	APPLICANT
Signature	Signature
STATE OF INDIANA)) SS: COUNTY OF MADISON)	
SUBSCRIBED and sworn to before me this day of	Nac ,2071
My Commission Expires: OFFICIAL SEAL REBECCA LYNN HUNTER NOTARY PUBLIC-STATE OF INDIANA HAMILTON COUNTY MY COMM. EXPIRES NOV 19, 2023 **********************************	
Inspector SN Date Inspected 5/20/22 Approved Rejected Rejected	
Date Reinspected Approved	Rejected
Notes: Size Pipe 6" Type Pipe 35	
Basement Yes No	North 1
Sump Pump <u>Yes No</u>	
Downspout to Ground <u>Yes No</u> Septic Tank Pumped & Filled <u>Yes No</u>	
Contractor Or Watson	Deal 12100.
Special Conditions	2
Existing Home New Construction	+
	1
	1 picture
	OCHOCK TO

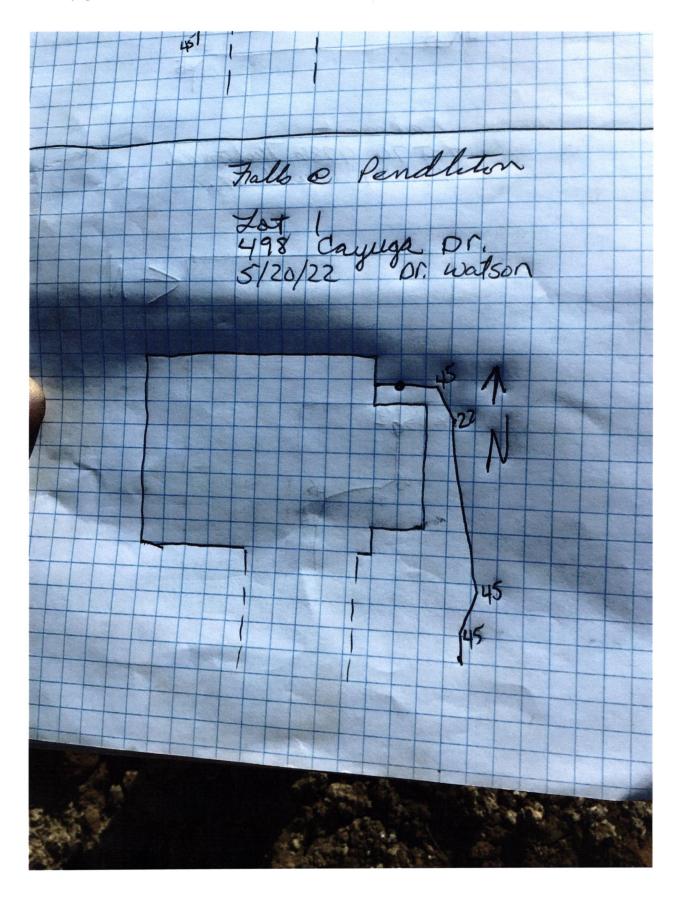

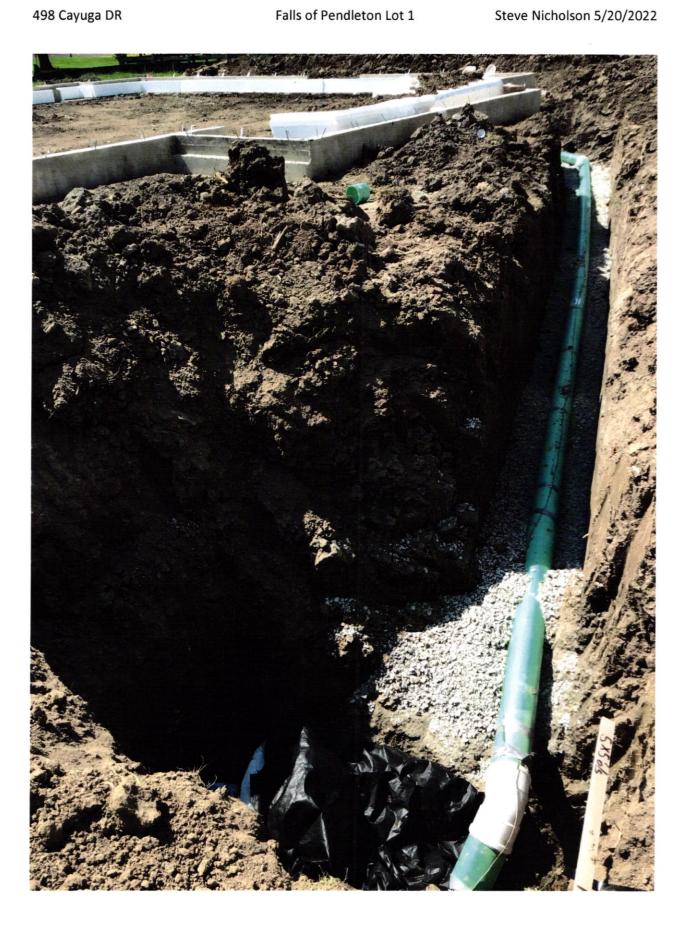

FALL CREEK REGIONAL WASTE DISTRI 9378 S 650 W PO BOX 59 PENDLETON, IN 46064 765-778-7544

FALL CREEK REGIONAL WASTE DIST

Date: 05/06/2021

10:00:27 AM

CREDIT CARD SALE

CARD NUMBER:

*******5166 K

TOTAL AMOUNT:

\$33,331.66

APPROVAL CD:

064394

RECORD #:

000 Becca

CLERK ID:

Tap & Grinder

CUST CODE: SALES TAX:

\$0.00

INVOICE #:

21 23 24 25 45

Thank you for your payment!

Customer Copy

Tap Fees

Lots Paid

1 2 5 7 14 18 20 21 23 24 25

\$760.00 x 11 = \$8360.00

Grinder Units

Lots Paid

18 20 21 23 24 25 45

\$3567.38 x 7 = \$24971.66

Units: \$23338.00

Tax:

\$1633.66

Receipt # 11695