
500 E Water ST 3/21/2024



500 E Water ST 3/21/2024

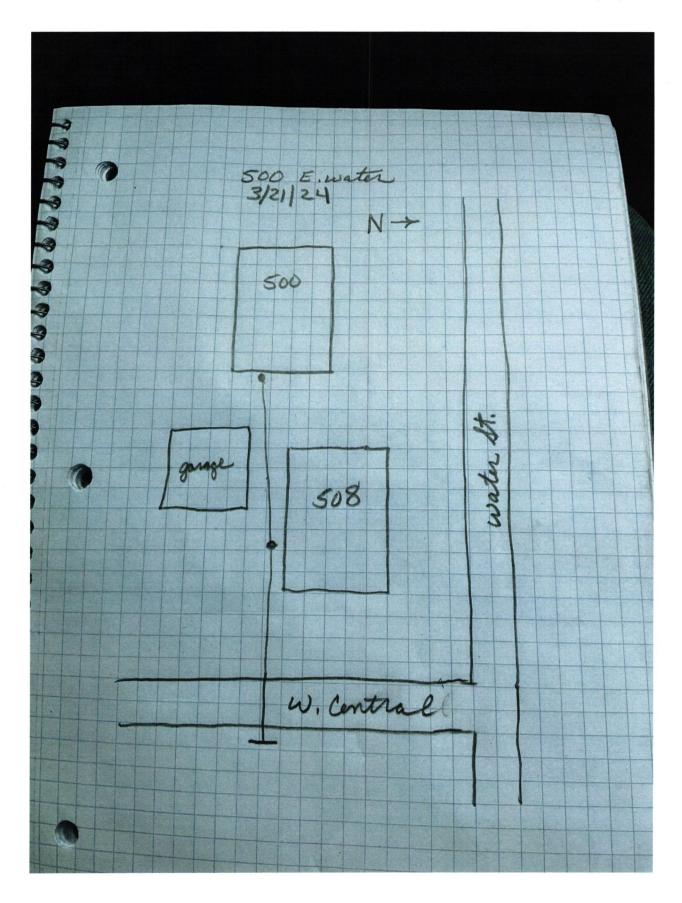