



FALL CREEK REGIONAL WASTE DISTRICT

9378 S. 650 West PO Box 59
Pendleton, IN 46064-0059 778-7544

add order
on file

22-15830.00

APPLICATION FOR SEWER PERMIT

Nº 2057

Date 4/19/94

Permit Void 90 days from Date of Issuance

Owner Name Doug Townsend

Property Address (500 S & 50 W) 5014 S. 50 W.

Lot # _____ P.O. Box _____

Town _____, IN Zip Code _____

Phone _____ City Water _____ Well ☒

\$ 700.00 Tap on Fee Paid

\$ 25.00 Inspection fee paid

Application is hereby made for connection to the Fall Creek Regional Waste District Sewer System for the above listed property - Permit Type: Residential ☒, Commercial _____, Industrial _____, or Governmental/Institutional _____. User Information _____.

All workmanship and materials shall conform to the standards of the District Ordinance as described in Ordinance 84-2 and 84-3 as amended. Acceptance and approval must be made by the District inspector or his duly authorized representative before backfilling and final connection is made to the main sewer lines. Any violation of applicable regulations will cause all lines and appurtenances in violation to be removed and replaced at the owners expense.

The Fall Creek Regional Waste District is responsible for the inspection, approval of materials, and installation techniques only. All costs for materials and installation and any liabilities resulting from same is the sole responsibility of the property owner.

I have read and fully understand the above provisions and agree to comply by said provisions.

APPLICANT(S) SIGNATURE

re-inspection 5/31/94 INSPECTOR TJM re-inspection 6/7/94
Date inspected 5-18-94 Approved ☒ Rejected _____ O.K.
Reason for rejection _____

Date reinspected _____ Approved _____ Rejected _____

Notes:

Size Pipe 6"

Type Pipe SDR 35

Basement Yes _____ No ☒

Sump Pump Yes _____ No ☒

Downspout to Ground Yes ☒ No _____


Septic Tank Pumped & filled Yes _____ No _____

Contractor Hall Mark

Special Conditions _____

Existing Home _____

New Construction ☒

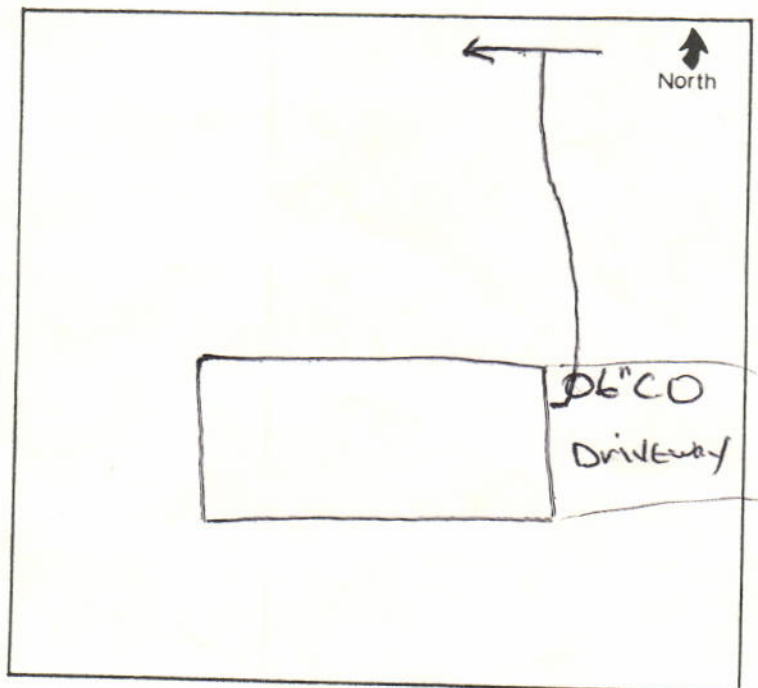



ROGER OR PAMELA SHOOT
ALL AMERICAN HOMES
SSN 306-56-2866 SSN 474-54-5503
820 MYERS AVE. 649-3131
ANDERSON, IN 46012-4161

5836

April 18 1994

71-70749

PAY TO THE
ORDER OF

Fall Creek Regional Waste District \$ 725.00

seven hundred twenty five and 00/100

DOLLARS

09-75



Citizens
Bank

Citizens Banking Co.
Anderson, Indiana 46015

MEMO


Townsend trip 5005/50W

Roger Shoot

⑆074900709⑆

5836

Roger & Pam Shoot
1518 Martin Dr.
Anderson, IN 46012

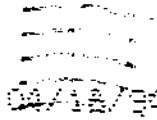

Fall Creek Regional Waste Dist.

P.O. Box 59

Pendleton In.

46064

Attn Teresa, Becky & Mary

needs a 6" clean-out
instead of a 4"