

Gidw.


PROJECT Phase II SHEET _____ OF _____

SUBJECT _____ DATE 4-26-18

JOB NO. 4447

BY At/As

501 W. State

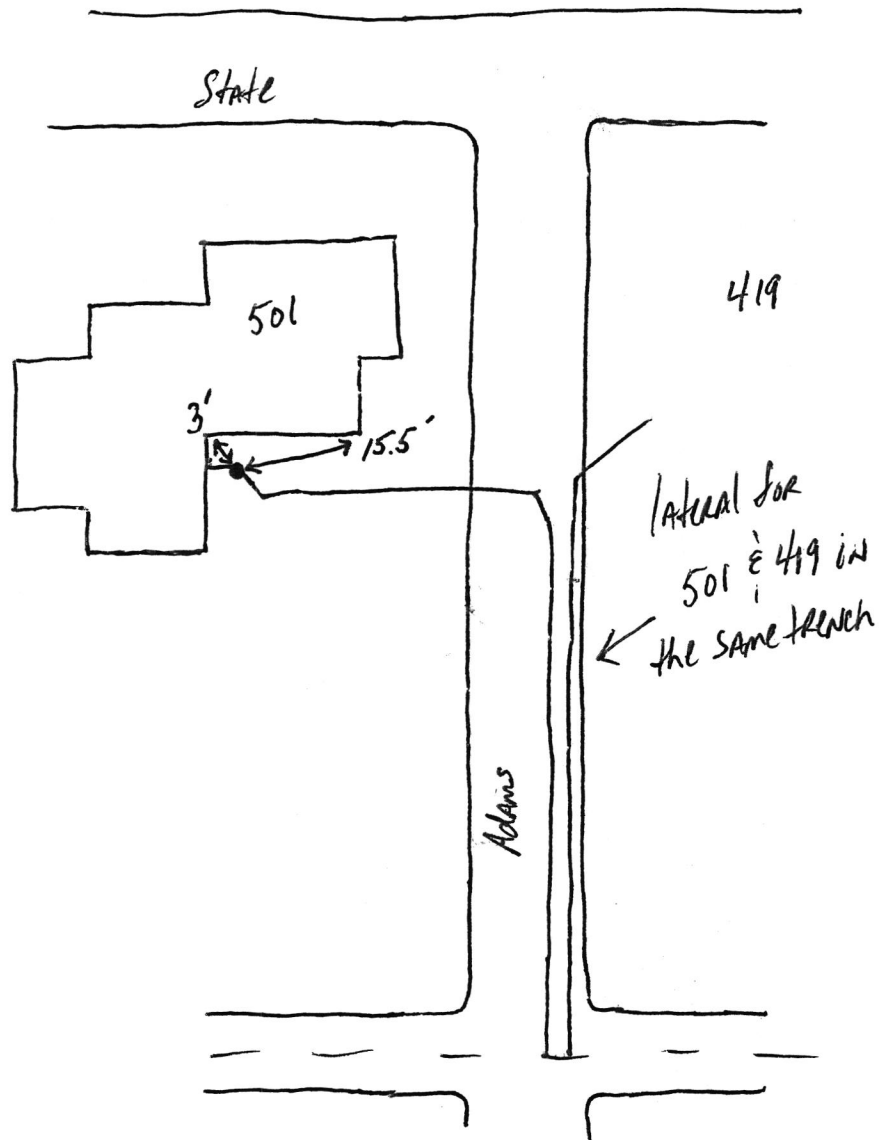

501 W State

SRF
Phase II

5.3.18



1-01496.00



FALL CREEK REGIONAL WASTE DISTRICT

9378 S. 650 West PO Box 59
Pendleton, IN 46064-0059 778-7544

Nº 2204

APPLICATION FOR SEWER PERMIT

Date 6-1-95

Permit Void 90 days from Date of Issuance

Owner Name Ron Hinton

Property Address 501 W. State St

Lot # _____ P.O. Box _____

Town Pendleton, IN Zip Code 46064

Phone _____ City Water X Well _____

\$ NA Tap on Fee Paid Clear out Replacement

\$ _____ Inspection fee paid

Application is hereby made for connection to the Fall Creek Regional Waste District Sewer System for the above listed property - Permit Type: Residential ☒, Commercial _____, Industrial _____, or Governmental/Institutional _____. User Information _____.

All workmanship and materials shall conform to the standards of the District Ordinance as described in Ordinance 84-2 and 84-3 as amended. Acceptance and approval must be made by the District inspector or his duly authorized representative before backfilling and final connection is made to the main sewer lines. Any violation of applicable regulations will cause all lines and appurtenances in violation to be removed and replaced at the owners expense.

The Fall Creek Regional Waste District is responsible for the inspection, approval of materials, and installation techniques only. All costs for materials and installation and any liabilities resulting from same is the sole responsibility of the property owner.

I have read and fully understand the above provisions and agree to comply by said provisions.

APPLICANT(S) SIGNATURE

INSPECTOR B

Date inspected 6-2 Approved _____ Rejected ✓

Reason for rejection Not complete

Date reinspected _____ Approved _____ Rejected _____

Notes: _____

Size Pipe 4 "

Type Pipe PVC

Basement Yes ☒ No _____

Sump Pump Yes _____ No _____

Downspout to Ground Yes ☒ No NA

Septic Tank Pumped & filled Yes ☒ No _____

Contractor Dan Foster (Signatures Plumb.)

Special Conditions SLEEVES IN A

NEW CLEAN OUT, (REPLACES OLD WATER PIT.)

Existing Home ☒

New Construction _____

