

Gidw.


PROJECT Phase II SHEET _____ OF _____

SUBJECT _____ DATE 2-14-18

JOB NO. 4447

BY Atlas

501 ~~S. Adams~~ Taylor

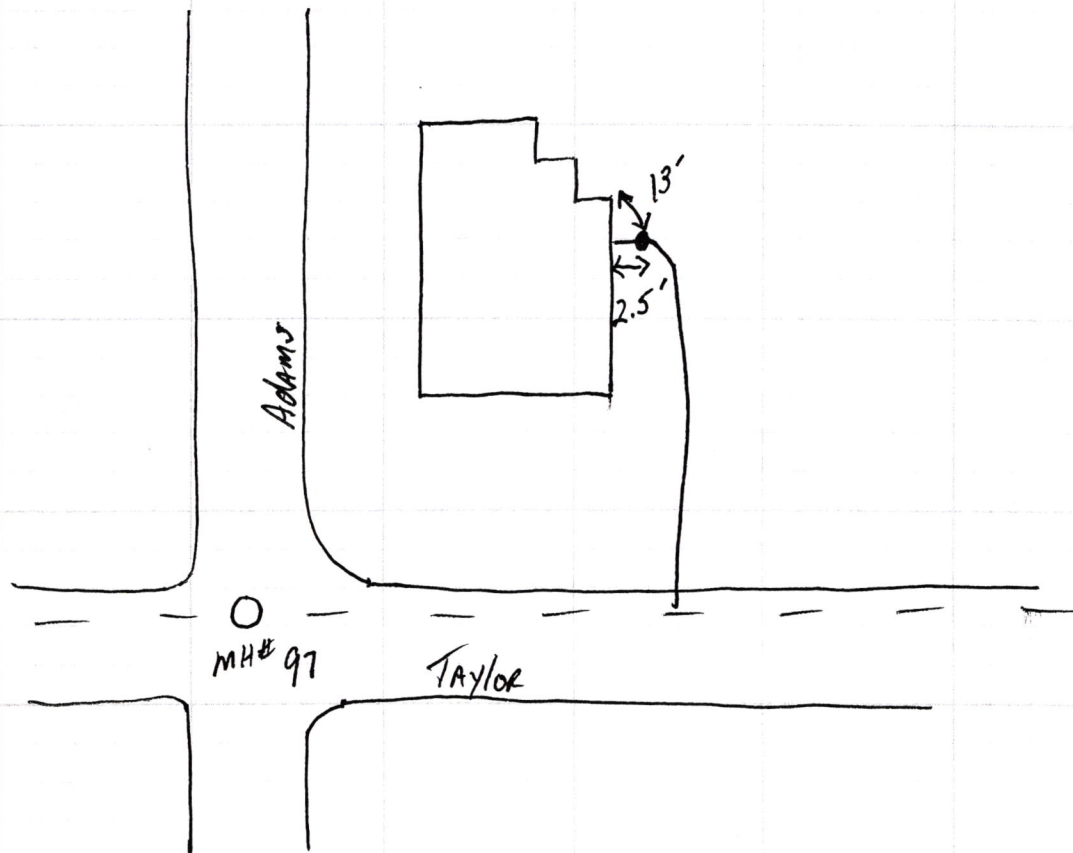

501 ~~S Adams~~
Taylor ST

SRP Phase II

2018

