


North

Drawing  
+  
3 pictures  
attached





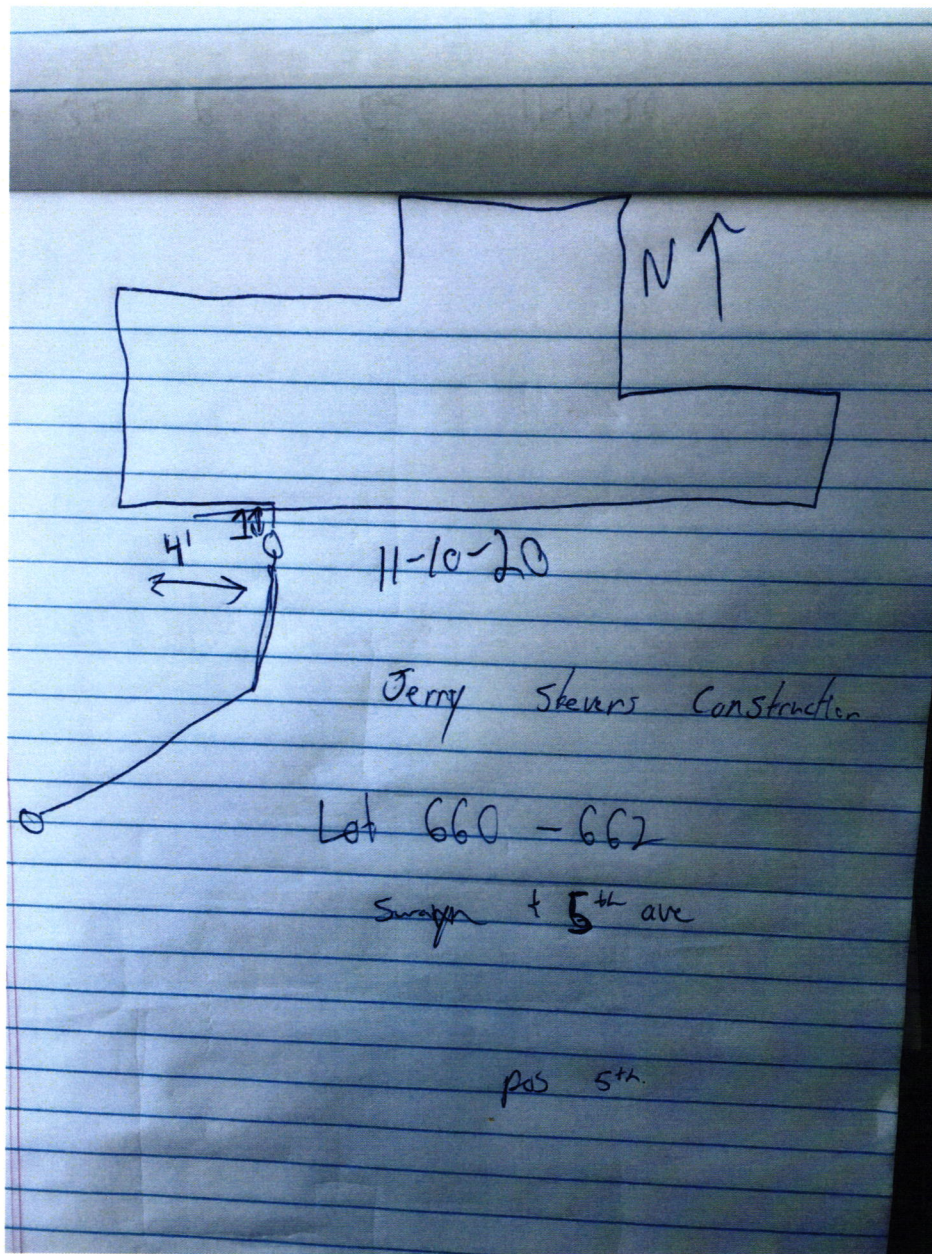















Jerry A Stevens Construction Inc  
35-1773016  
5554 W 300 N  
Rushville, IN 46173-8612

7389

71-7110/2749

Date 11/2/2020


Pay to the Order of FLRWD

\$ 4160<sup>00</sup>

four thousand one hundred sixty and


00

Dollars

 Security details on back.

USLA  
Connersville, IN 47331

For Sever Kermit

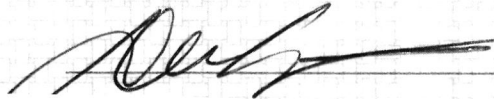

MP

Rec # 011430