

add orders
on file



FALL CREEK REGIONAL WASTE DISTRICT

9378 S. 650 West PO Box 59
Pendleton, IN 46064-0059 778-7544

101 W Madison #3-05763.99
504 S Pendleton 3-05765.99

APPLICATION FOR SEWER PERMIT

No 2193

Date 5/2/95

Permit Void 90 days from Date of Issuance

Owner Name Bryce Lewis

Property Address 101 W Madison & 504 S Pendleton Ave

Lot # _____

P.O. Box _____

Town Pendleton

IN Zip Code 46064

Phone _____

City Water ☒ Well _____

\$ 700.00

Tap on Fee Paid

\$ 725 credit from
existing house

\$ 25.00

Inspection fee paid

Application is hereby made for connection to the Fall Creek Regional Waste District Sewer System for the above listed property - Permit Type: Residential ☒, Commercial _____, Industrial _____, or Governmental/Institutional _____. User Information _____.

All workmanship and materials shall conform to the standards of the District Ordinance as described in Ordinance 84-2 and 84-3 as amended. Acceptance and approval must be made by the District inspector or his duly authorized representative before backfilling and final connection is made to the main sewer lines. Any violation of applicable regulations will cause all lines and appurtenances in violation to be removed and replaced at the owners expense.

The Fall Creek Regional Waste District is responsible for the inspection, approval of materials, and installation techniques only. All costs for materials and installation and any liabilities resulting from same is the sole responsibility of the property owner.

I have read and fully understand the above provisions and agree to comply by said provisions.

Bryce Lewis

APPLICANT(S) SIGNATURE

INSPECTOR Tim

Date inspected 8/95

Approved ☒

Rejected ☒

Reason for rejection _____

Date reinspected _____

Approved _____

Rejected _____

Notes:

Size Pipe 6"

Type Pipe SDR 35

Basement Yes _____ No ☒

Sump Pump Yes _____ No ☒

Downspout to Ground Yes ☒ No _____

Septic Tank Pumped & filled Yes _____ No _____


Contractor Dick Goodby

Special Conditions (Did not BED

PIPE)

Existing Home _____

New Construction ☒

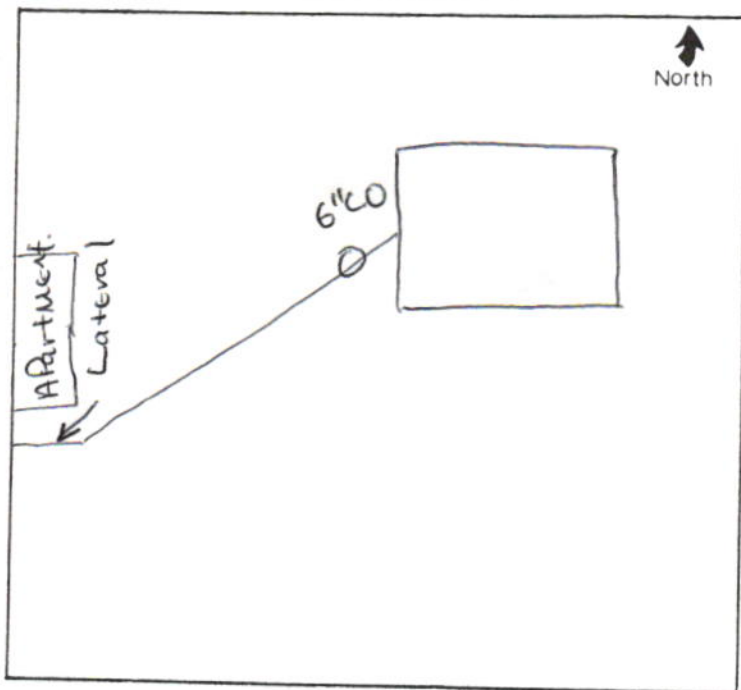

BRYCE L OR MARLA A LEWIS 12/83
311-52-1273 306-50-9402
3892 ARROWHEAD CT PH 326-4175
GREENFIELD IN 46140

2902

71-7257/2749

May 2 19 95

PAY TO THE
ORDER OF

FALL CREEK REGIONAL WASTE DISTRICT \$ 725⁰⁰/₁₀₀

SEVEN HUNDRED TWENTY FIVE ⁰⁰/₁₀₀ DOLLARS

INDEPENDENT FEDERAL

ANDERSON, INDIANA 46016

CREDIT UNION

FOR

SEWER TAP

⑆274972579⑆

2902