

Gidw.


PROJECT Phase II SHEET _____ OF _____

SUBJECT _____ DATE 3-16-18

JOB NO. 4447

BY Atlas

504 Taylor

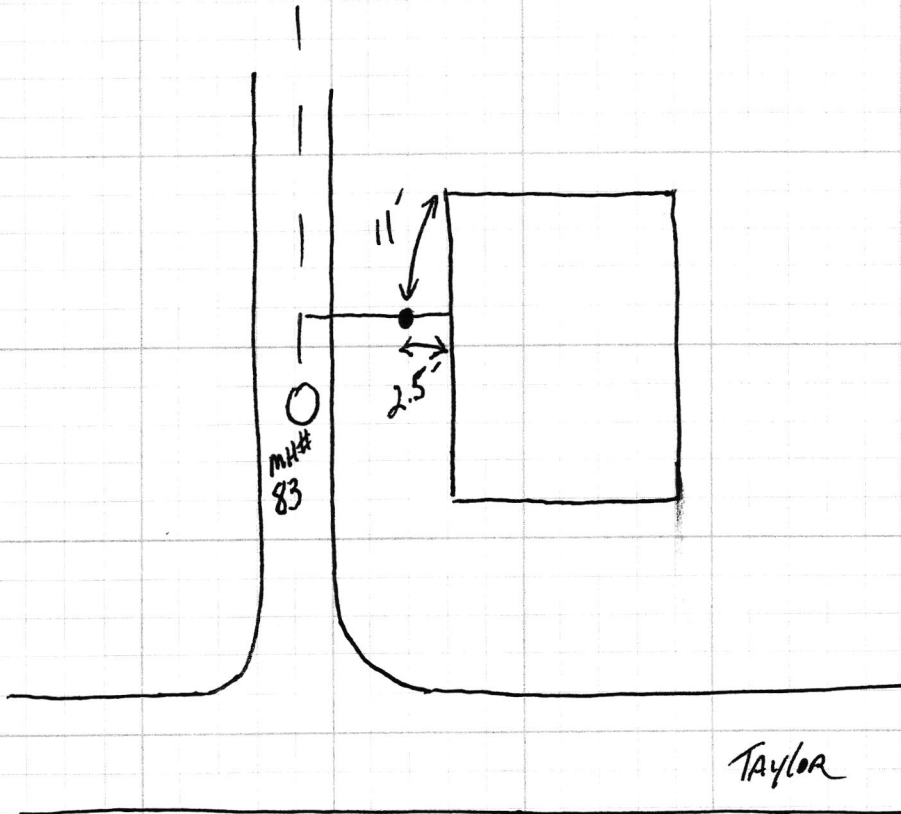

504 Taylor

SRP Phase II

