

Gidw.

PROJECT PHASE II SHEET _____ OF _____


SUBJECT _____ DATE 6-28-18

JOB NO. 4447

BY ATLAS

506 S. CENTER ST.

N →

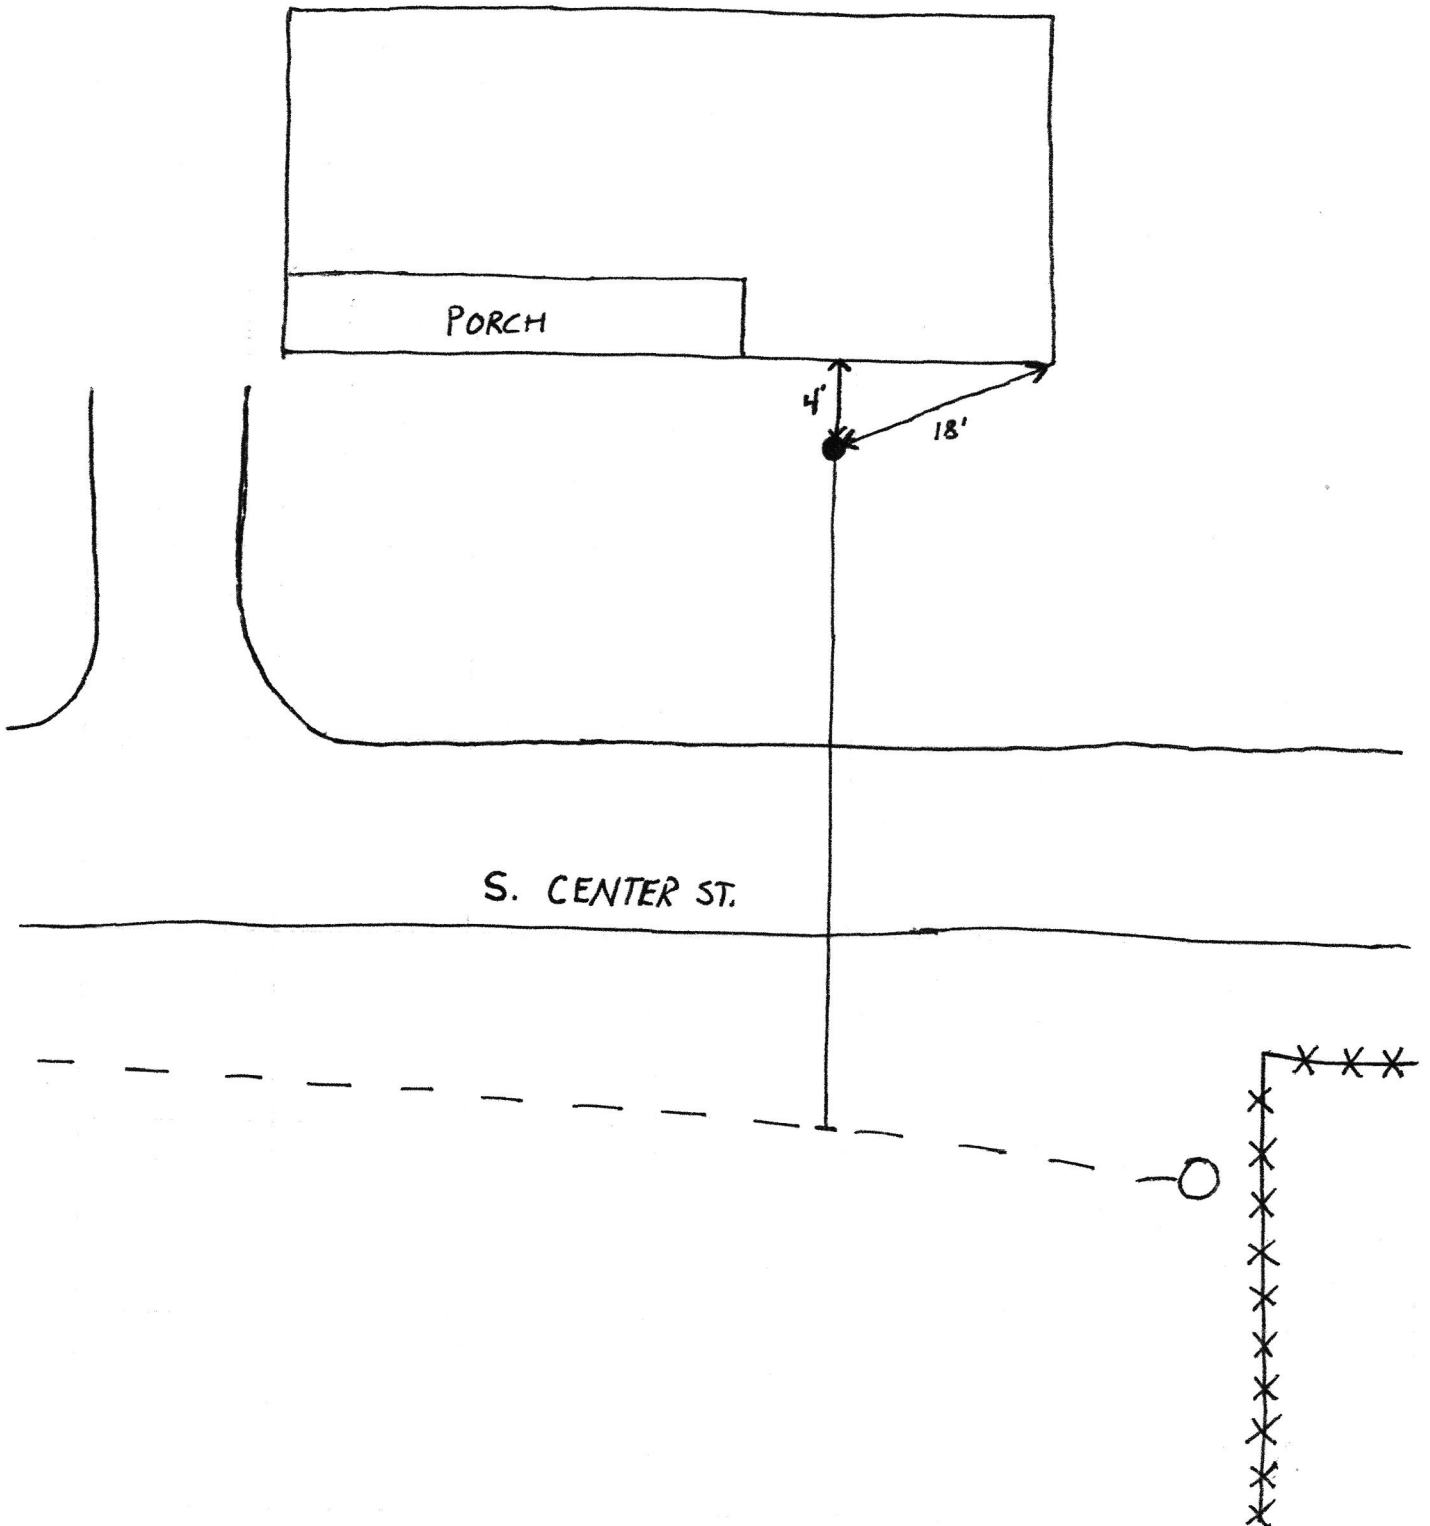

Solo Center

Srf Phase II

7.6.18

