

Gidw.


PROJECT Phase II SHEET _____ OF _____

SUBJECT _____ DATE 3-23-18

JOB NO. 4447

BY Atlas

508 W. High

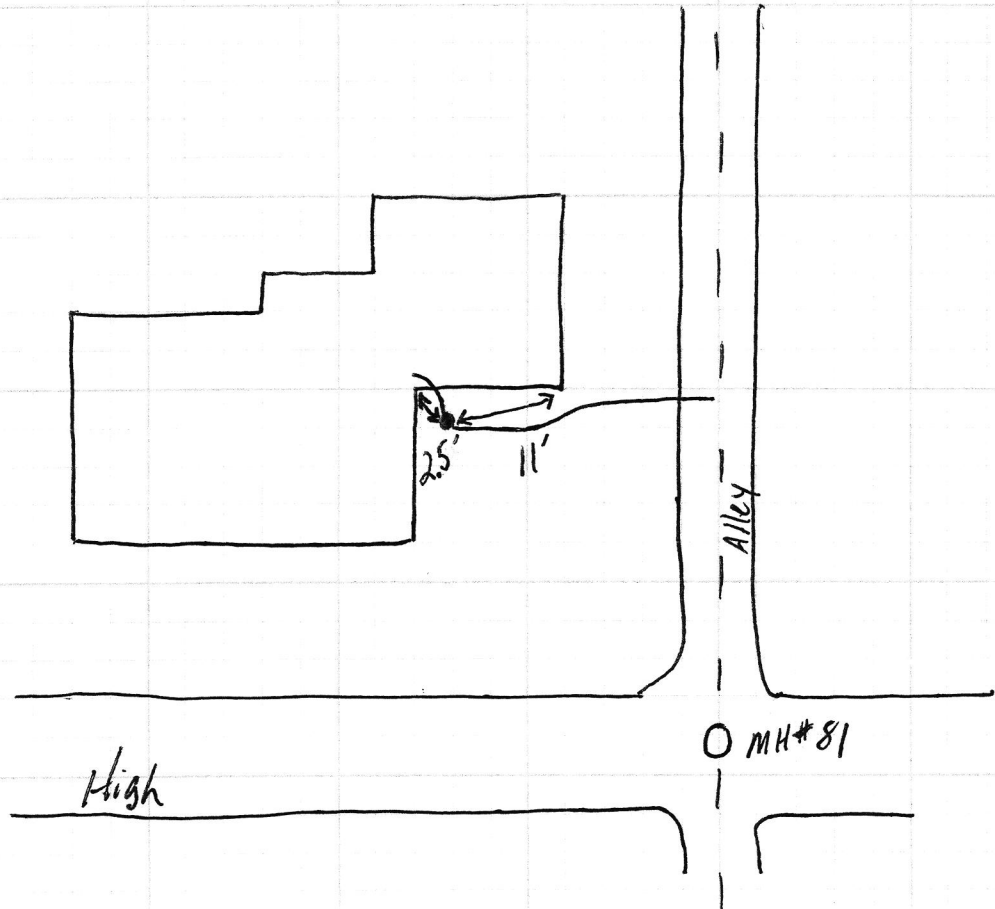

508 W High

SRF Phase II

