

Gidw.


PROJECT Phase II SHEET _____ OF _____

SUBJECT _____ DATE 4-13-18

JOB NO. 4447

BY Atlas

509 W. State

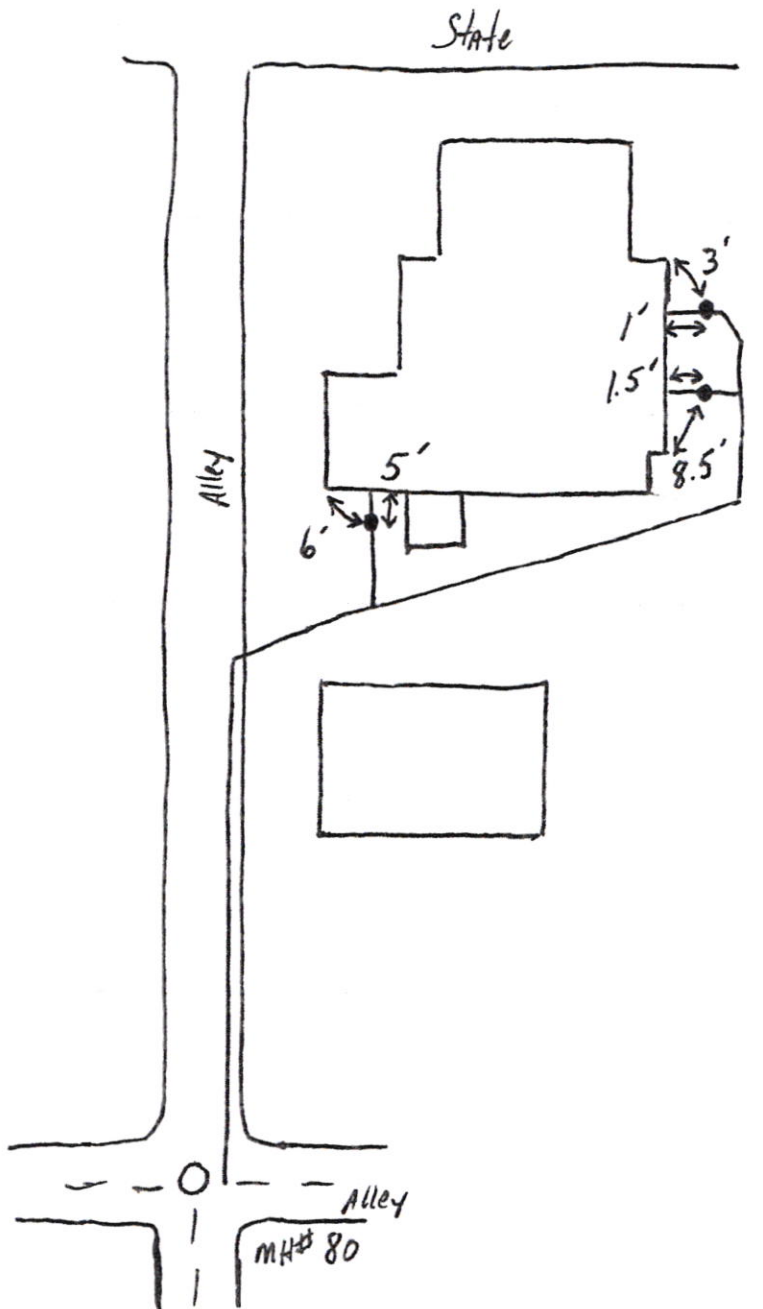

509 W State

SRP
Phase II

4.20.18



509 W State

SRP
Phase II

4.20.18

