


Gidw.

PROJECT Phase II SHEET _____ OF _____
SUBJECT _____ DATE 2-16-18
JOB NO. 4447
BY Atlas

509 W. Taylor

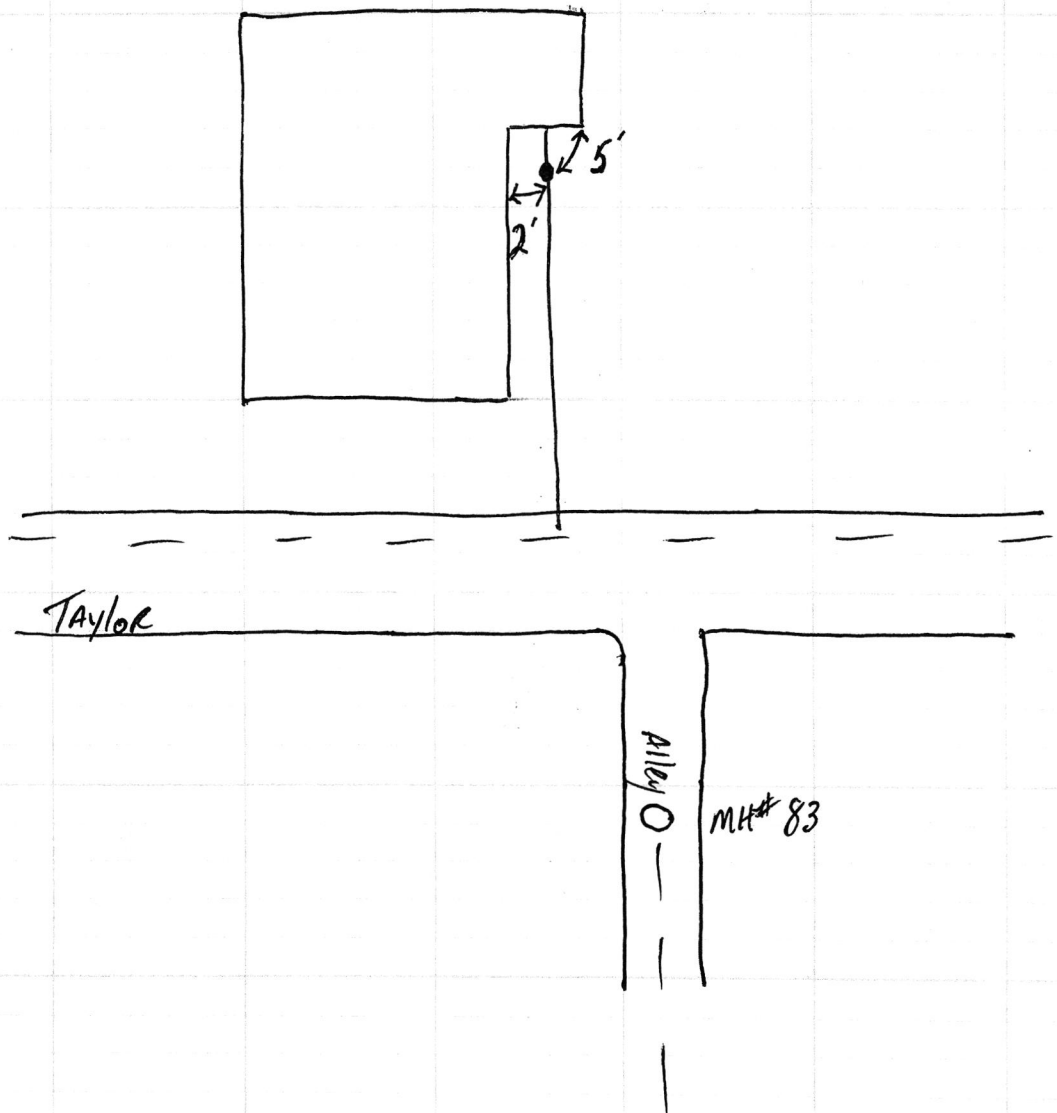

509 W Taylor

SRP Phase II

