



# FALL CREEK REGIONAL WASTE DISTRICT

9378 S. 650 West PO Box 59  
Pendleton, IN 46064-0059 778-7544

7-14893.00

## APPLICATION FOR SEWER PERMIT

Nº 2798

Date 6/6/00

Permit Void 90 days from Date of Issuance

Owner Name Al Swinford

Property Address 510 Broadway

Lot # 5 & 6 Parcel "C" P.O. Box \_\_\_\_\_

Town Pendleton, IN Zip Code \_\_\_\_\_

Phone 317-849-0325 City Water ☒ Well \_\_\_\_\_

\$ 2300.00 Tap on Fee Paid

\$ \_\_\_\_\_ Inspection fee paid

Application is hereby made for connection to the Fall Creek Regional Waste District Sewer System for the above listed property - Permit Type: Residential ☒, Commercial \_\_\_\_\_, Industrial \_\_\_\_\_, or Governmental/Institutional \_\_\_\_\_. User Information \_\_\_\_\_.

All workmanship and materials shall conform to the standards of the District Ordinance as described in Ordinance 84-2 and 84-3 as amended. Acceptance and approval must be made by the District inspector or his duly authorized representative before backfilling and final connection is made to the main sewer lines. Any violation of applicable regulations will cause all lines and appurtenances in violation to be removed and replaced at the owners expense.

The Fall Creek Regional Waste District is responsible for the inspection, approval of materials, and installation techniques only. All costs for materials and installation and any liabilities resulting from same is the sole responsibility of the property owner.

I have read and fully understand the above provisions and agree to comply by said provisions.

James E. Coffey

APPLICANT(S) SIGNATURE

INSPECTOR TIM

Date inspected 7-31-00 Approved ☒ Rejected \_\_\_\_\_

Reason for rejection \_\_\_\_\_

Date reinspected \_\_\_\_\_ Approved \_\_\_\_\_ Rejected \_\_\_\_\_

### Notes:

Size Pipe 6"

Type Pipe SDR35

Basement Yes \_\_\_\_\_ No ☒

Sump Pump Yes \_\_\_\_\_ No ☒

Downspout to Ground Yes \_\_\_\_\_ No \_\_\_\_\_


Septic Tank Pumped & filled Yes \_\_\_\_\_ No \_\_\_\_\_

Contractor FREDRICKS EXCAV.

Special Conditions \_\_\_\_\_

Existing Home \_\_\_\_\_

New Construction ☒

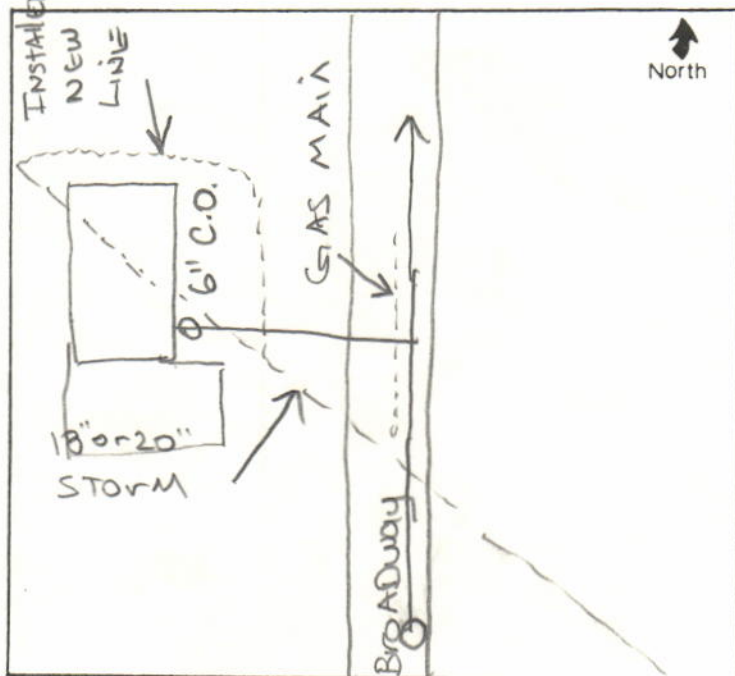

**JIM COFFEY CONSTRUCTION**

11732 E. 126TH STREET PH. (317) 849-0325  
FISHERS, IN 46038

COMMUNITY BANK  
NOBLESVILLE, IN 46060  
71-538/749

34333

6/6/2000

PAY TO THE ORDER OF Fall Creek Regional Wastewater

\$ \*\*2,300.00

Two Thousand Three Hundred and 00/100\*\*\*\*\*

Fall Creek Regional Wastewater

DOLLARS  
Security features  
included.  
Details on back.

MEMO 510 S. Broadway - Lots 5 & 6 - Parcel "C", Alan Swinford

⑈034333⑈ ⑆074905380⑆

