

GIS


PROJECT PHASE II SHEET _____ OF _____

SUBJECT _____ DATE 6-27-18

JOB NO. 4447

BY ATLAS

511 S. CENTER ST.

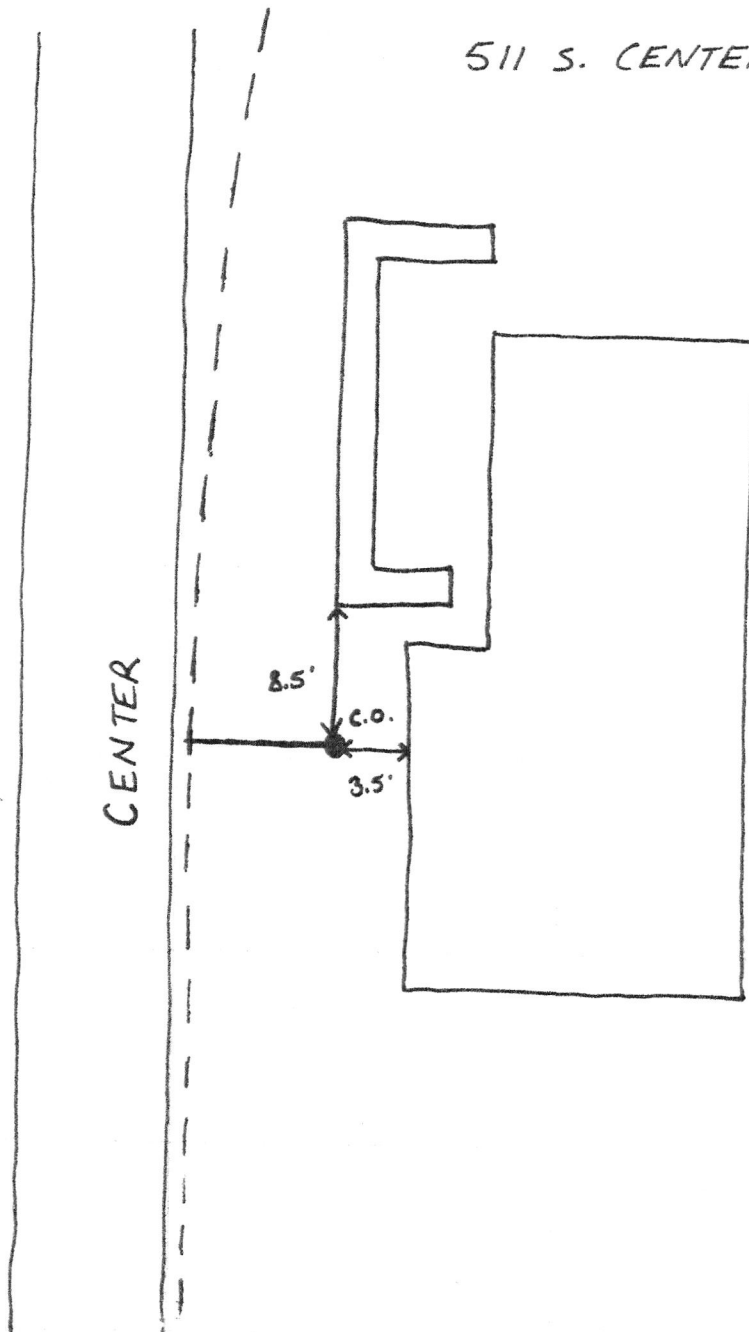

511 Center

Sgt Phase II

7-6-18

