


Gidw.

PROJECT Phase II SHEET _____ OF _____
SUBJECT _____ DATE 4-19-18
JOB NO. 4447
BY Atlas

511 S. Broadway

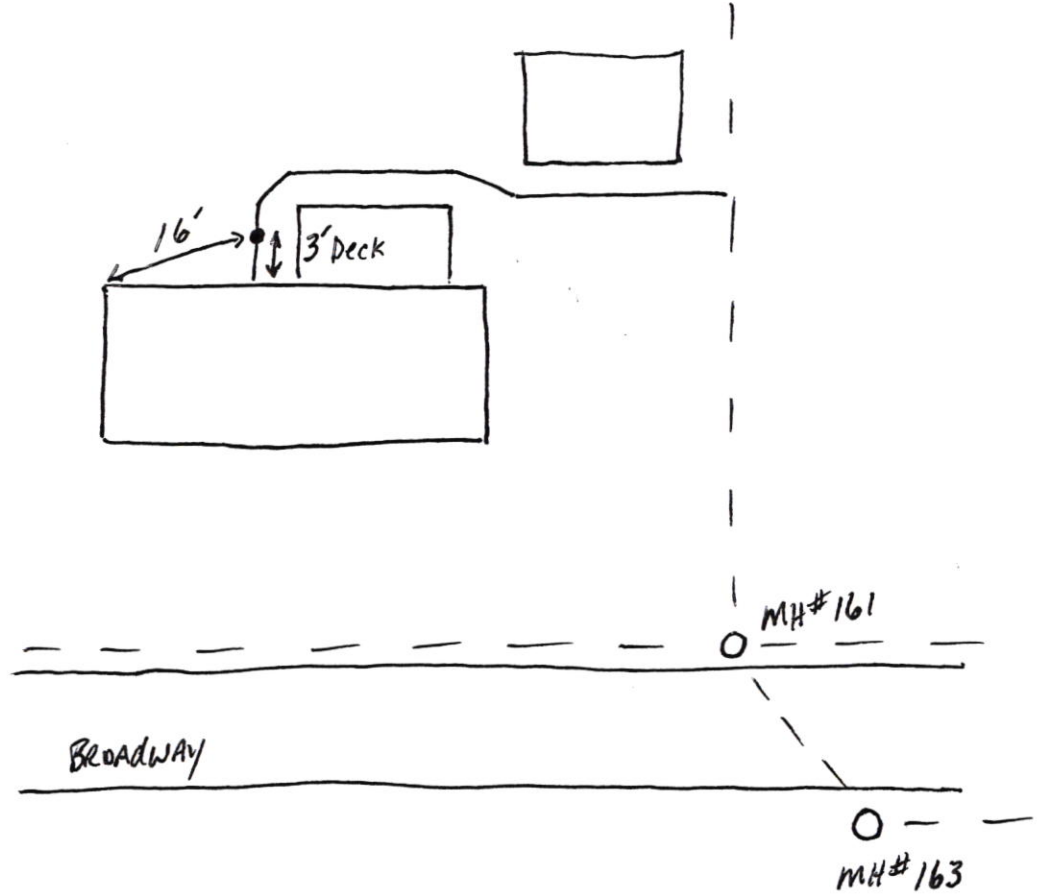

511 S Broadway

SRP
Phase II

4-20-18

