


Gidw.

PROJECT Phase II SHEET \_\_\_\_\_ OF \_\_\_\_\_  
SUBJECT \_\_\_\_\_ DATE 4-19-18  
JOB NO. 4447  
BY Atlas


511 S. Broadway

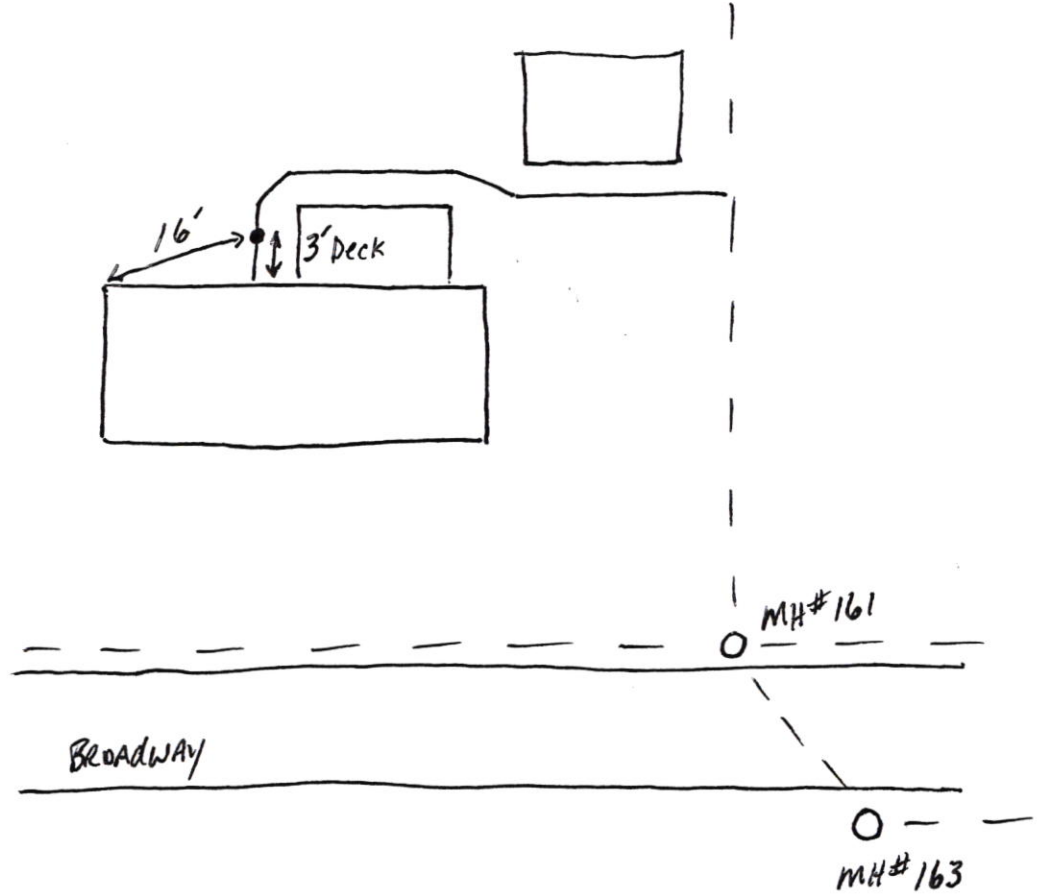


511 S Broadway

SRP  
Phase II

4-20-18

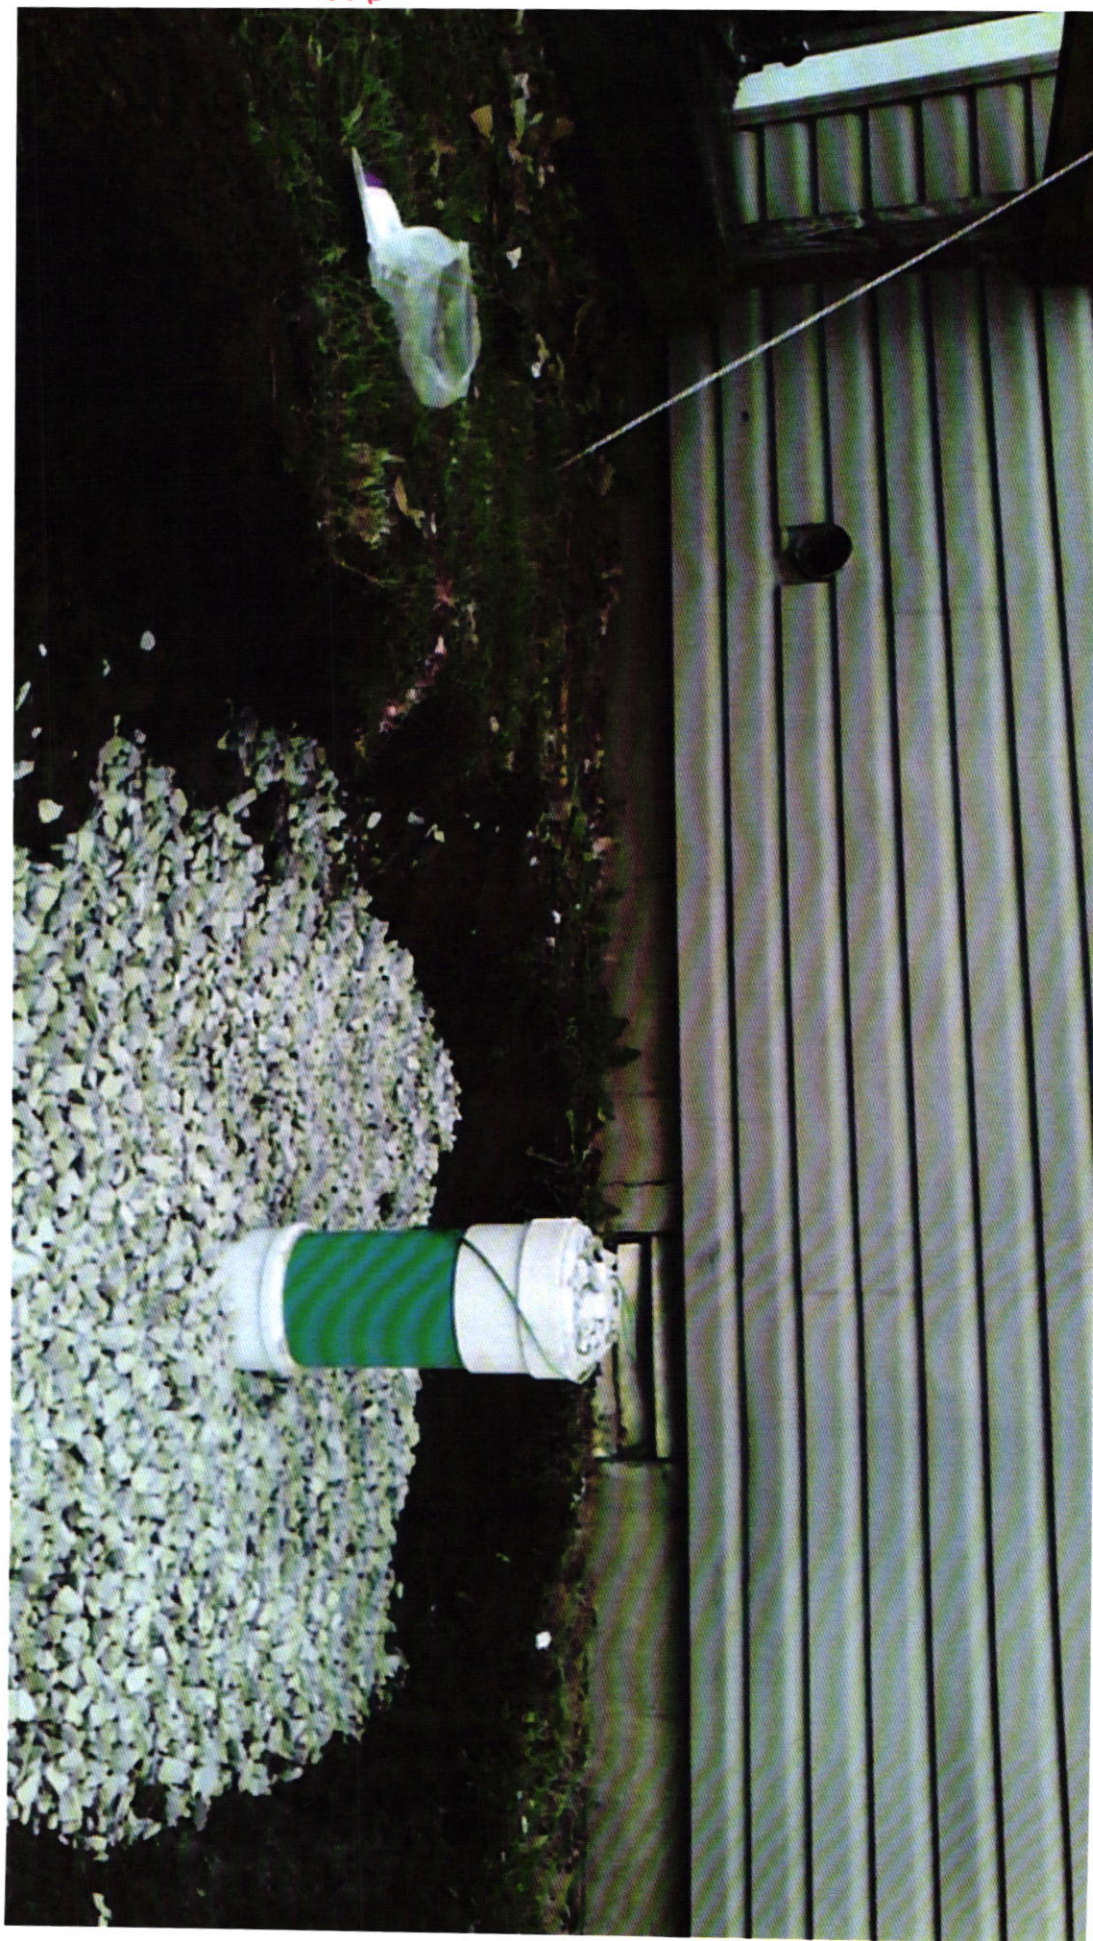

511 S Broadway 5-2-22 Campbell's Ex

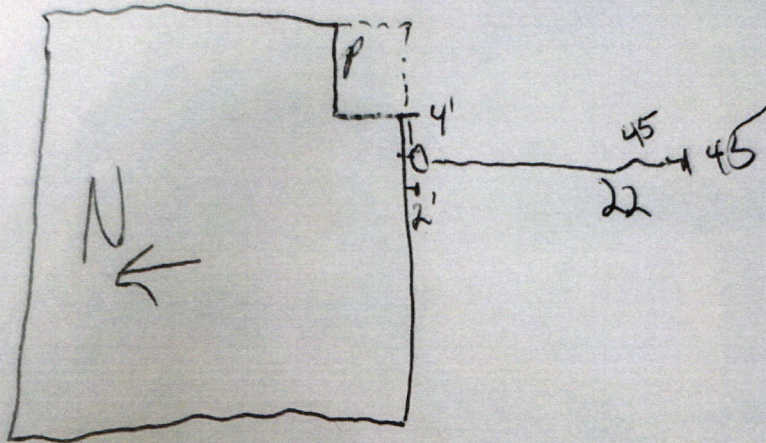

10"  $\frac{7}{8}$  Higher than Ex-Tap





