


Gidw.

PROJECT Phase II SHEET _____ OF _____
SUBJECT _____ DATE 4-16-18
JOB NO. 4447
BY Atlas

513 W. State

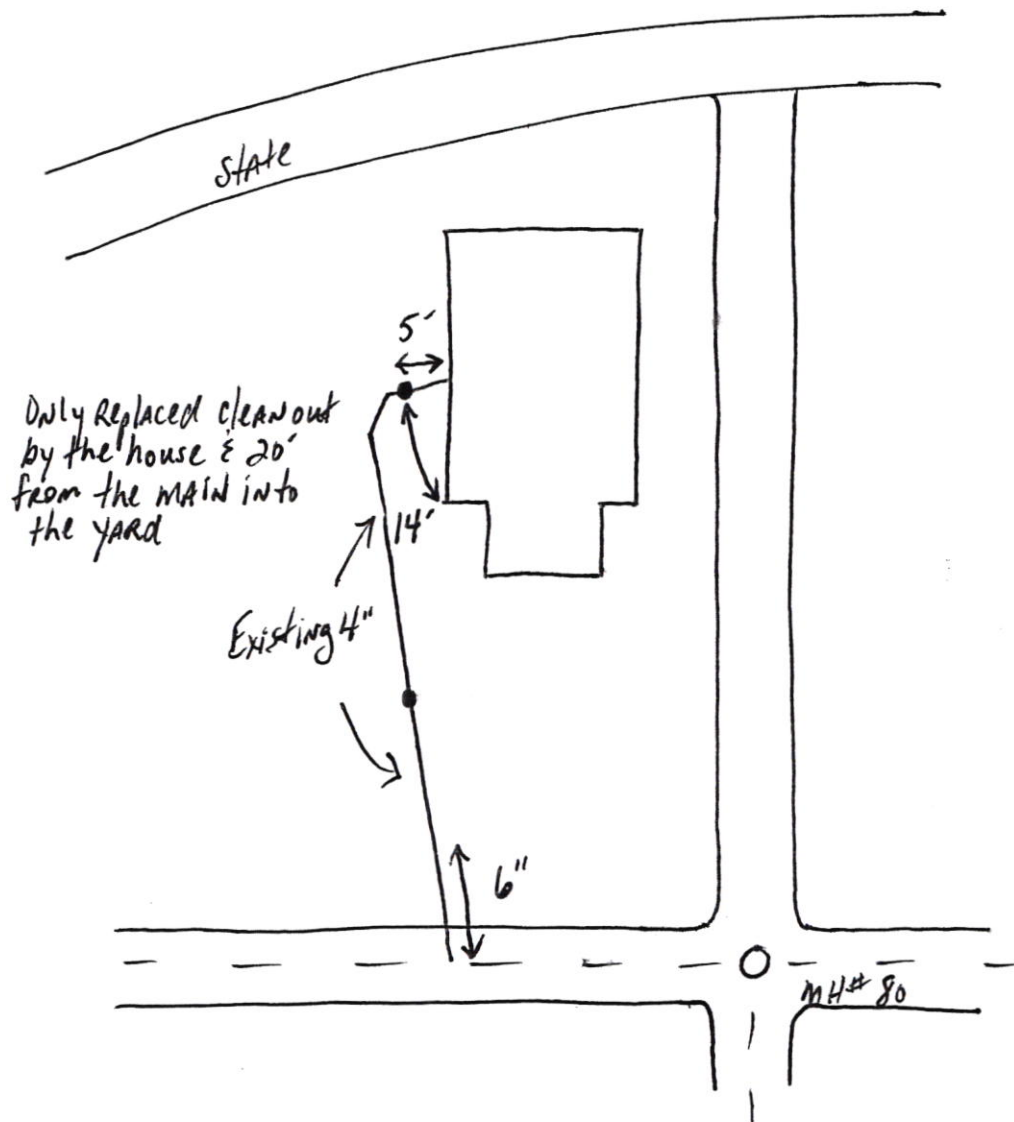

513 W State

SRF
Phase II

4.20.18



