




PROJECT Phase II SHEET _____ OF _____

SUBJECT _____ DATE 1-19-18

JOB NO. 4447

BY Atlas

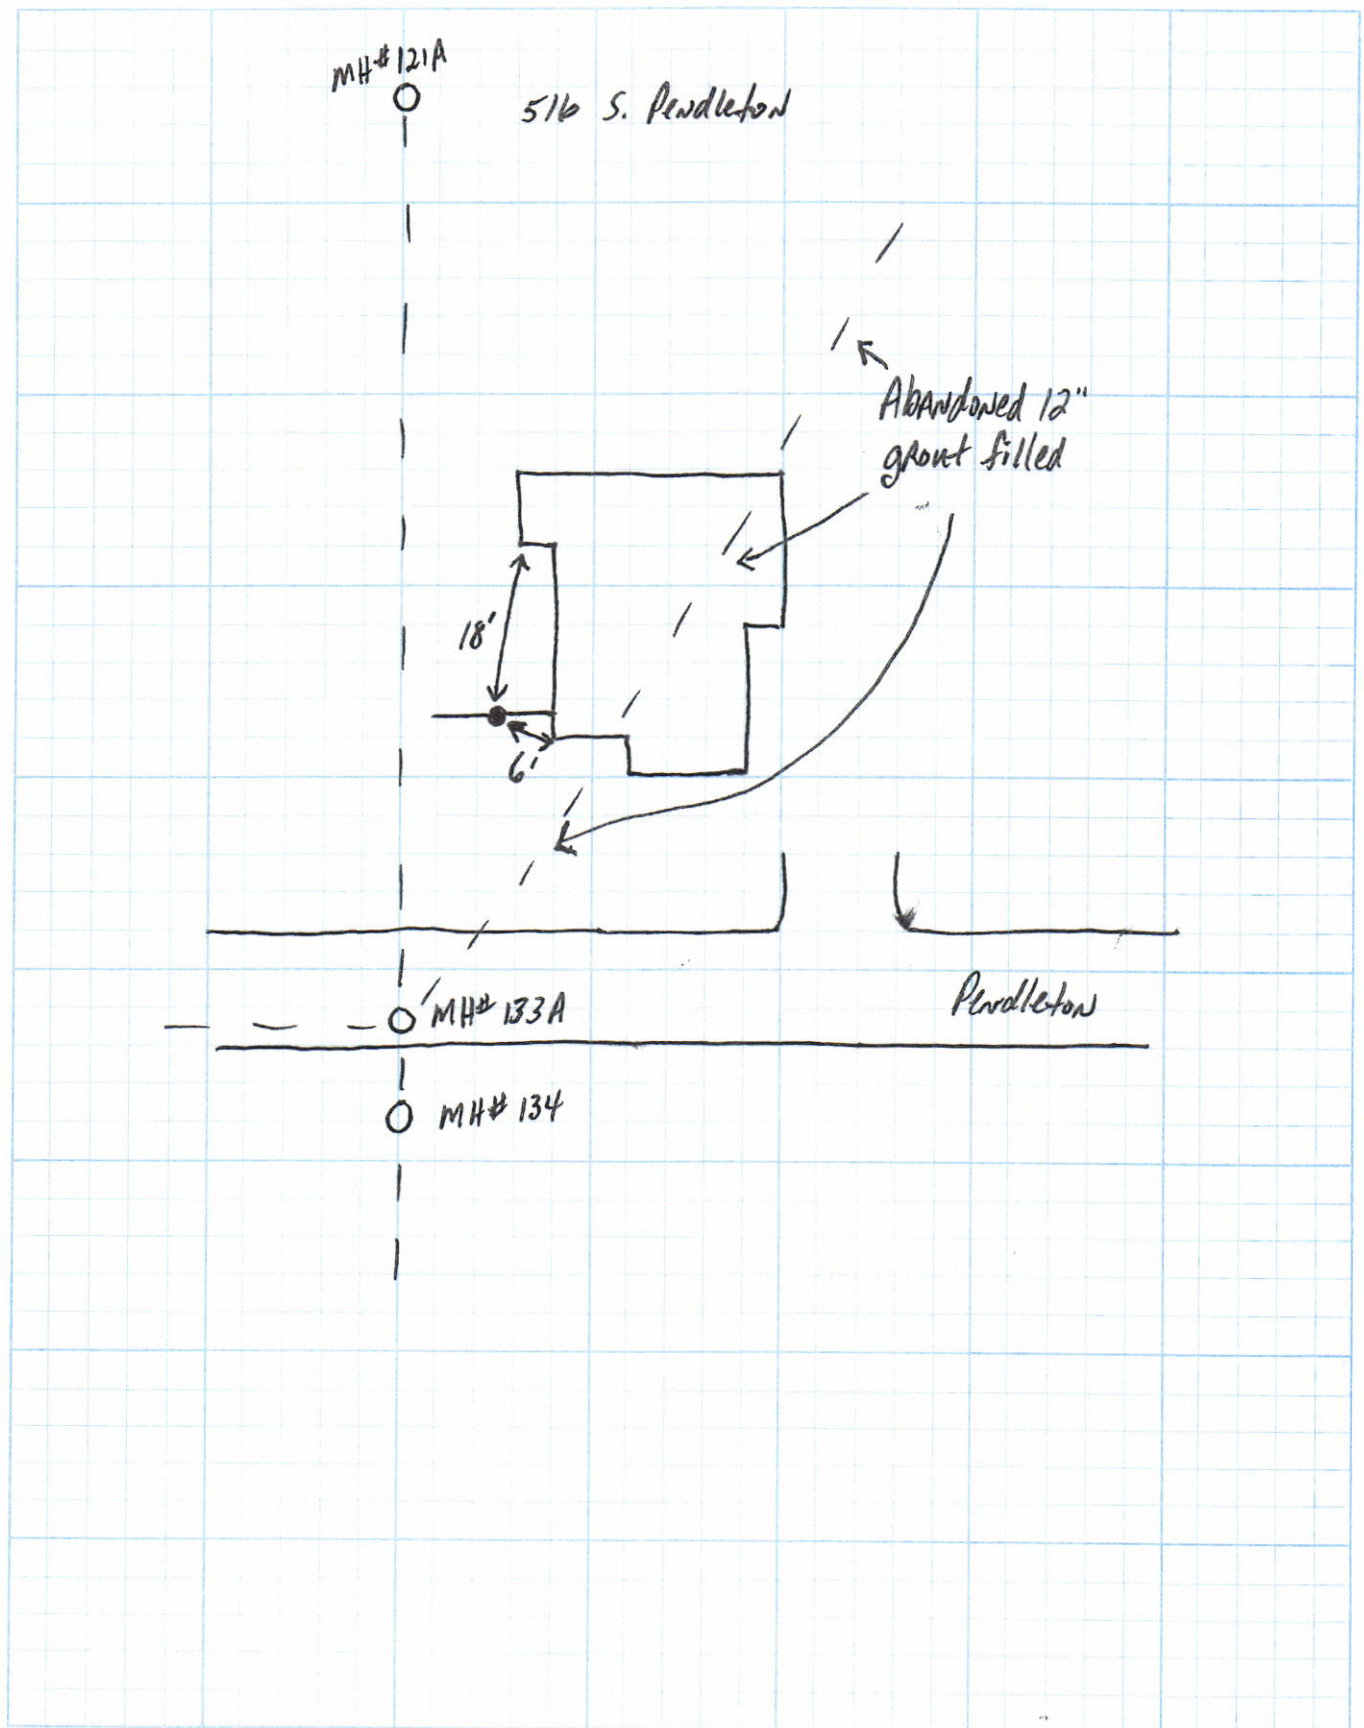

516 S Pendleton Ave SRP Phase II

Jan 2018

