


Gidw.

PROJECT Phase II SHEET _____ OF _____
SUBJECT _____ DATE 4-11-18
JOB NO. 4447
BY AHAS

516 W. High

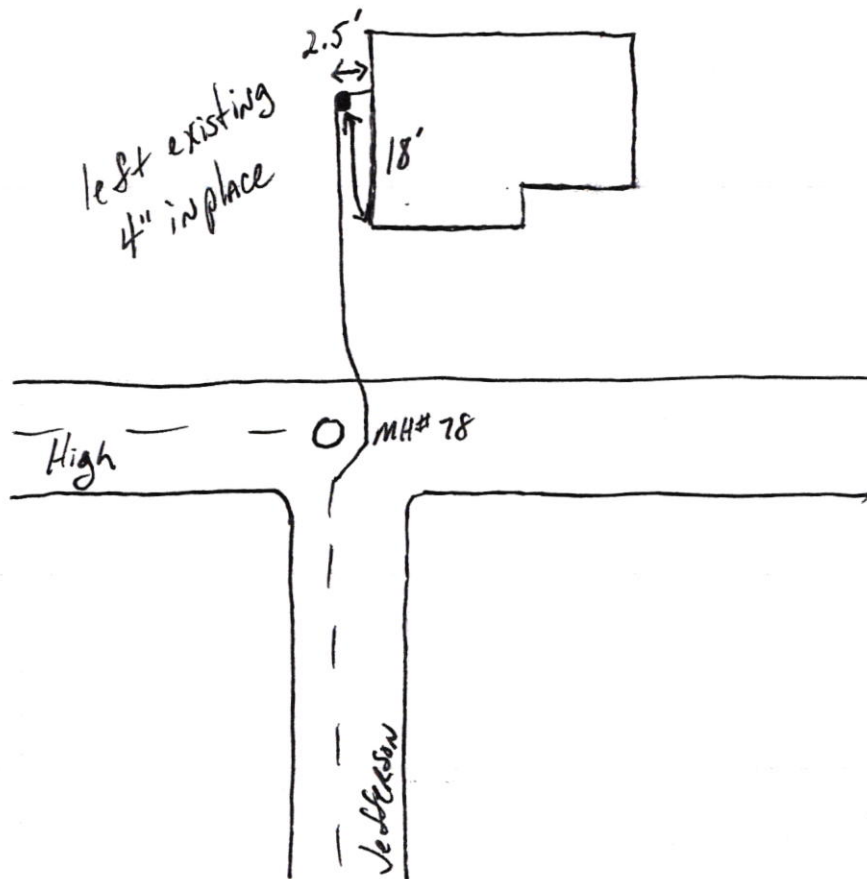

Site W High

SRF
Phase II

4.20.18

