

Gidw.


PROJECT Phase SHEET \_\_\_\_\_ OF \_\_\_\_\_

SUBJECT \_\_\_\_\_ DATE 3-19-18

JOB NO. 4447

BY Atlas

520 Taylor

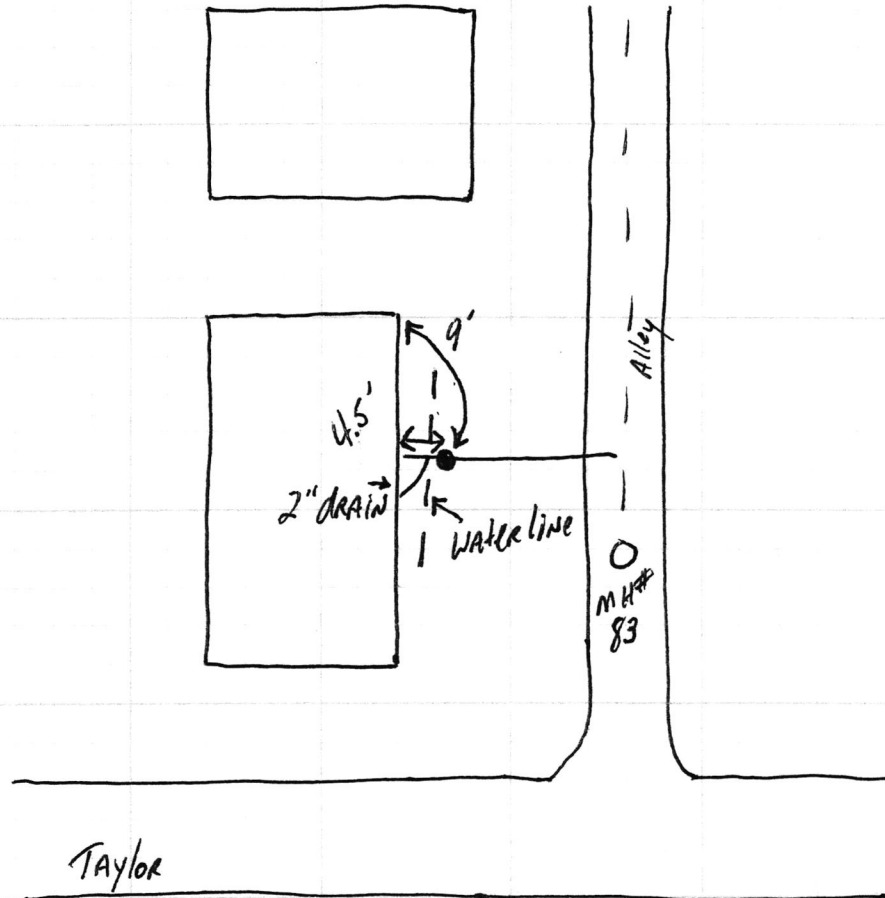

520 Taylor

SRP Phase II

